


# T.9S. R.1W., W.M.

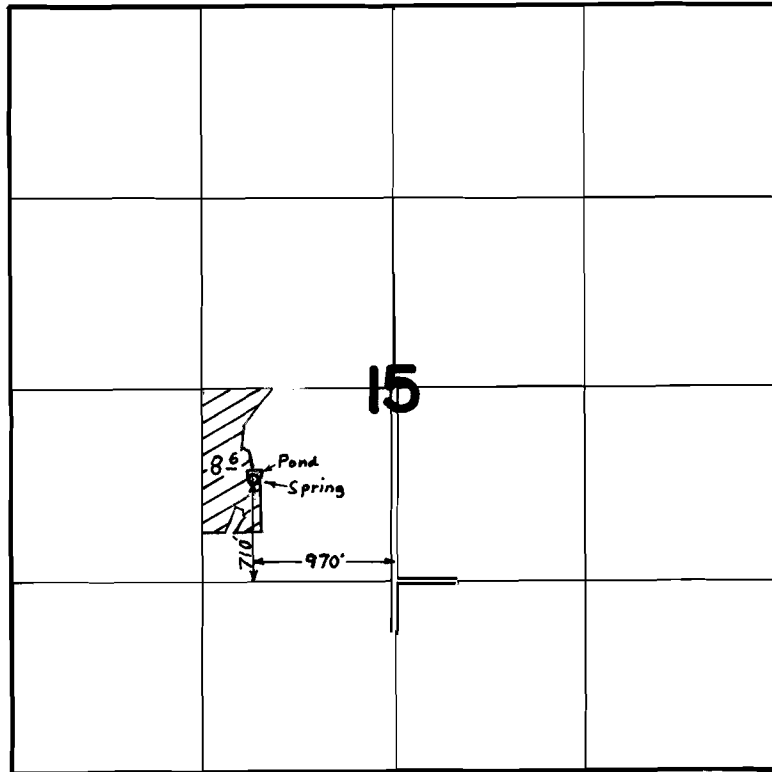

## FINAL PROOF SURVEY UNDER

Application No. 53488... Permit No. 39790...  
IN NAME OF

.....RALPH E. PHILLIPS.....

Surveyed APR. 12. 1978., by S. P. APPLGATE