


T. 11 S., R. 2 W., W. M.

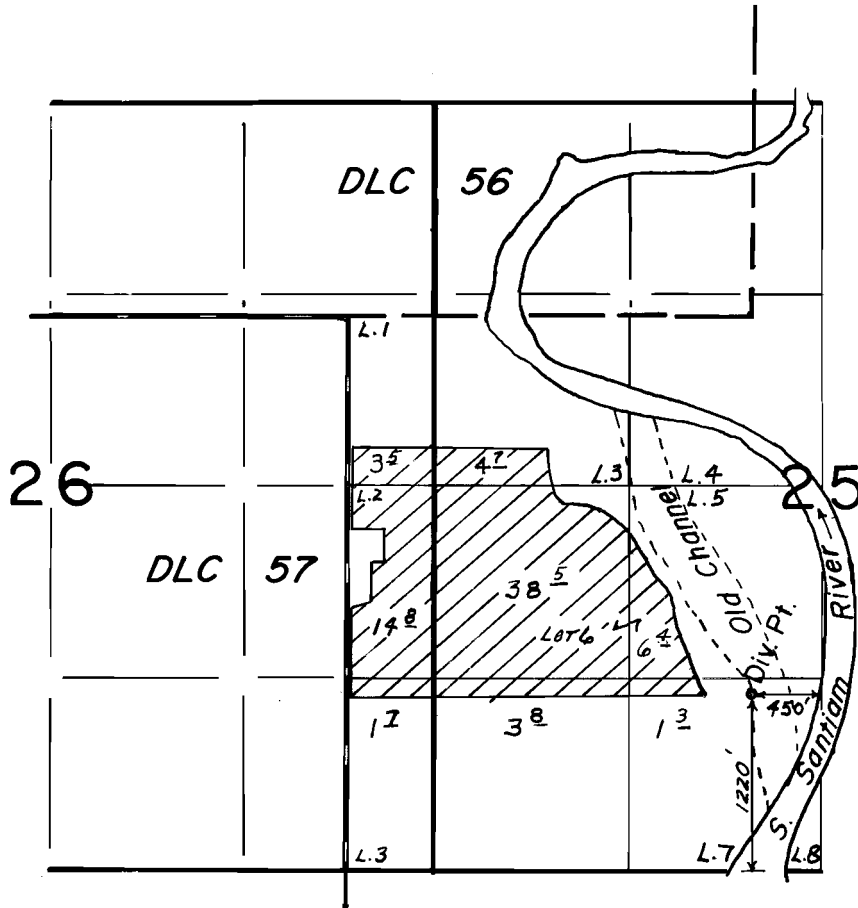

FINAL PROOF SURVEY
UNDER

Application No. 55279... Permit No. 41426...
IN NAME OF

..... JOHN BLACKLAW

Surveyed Sept. 7... 19.78, by J.S. DONALDSON