


T. 7S. R. 1W. W.M.

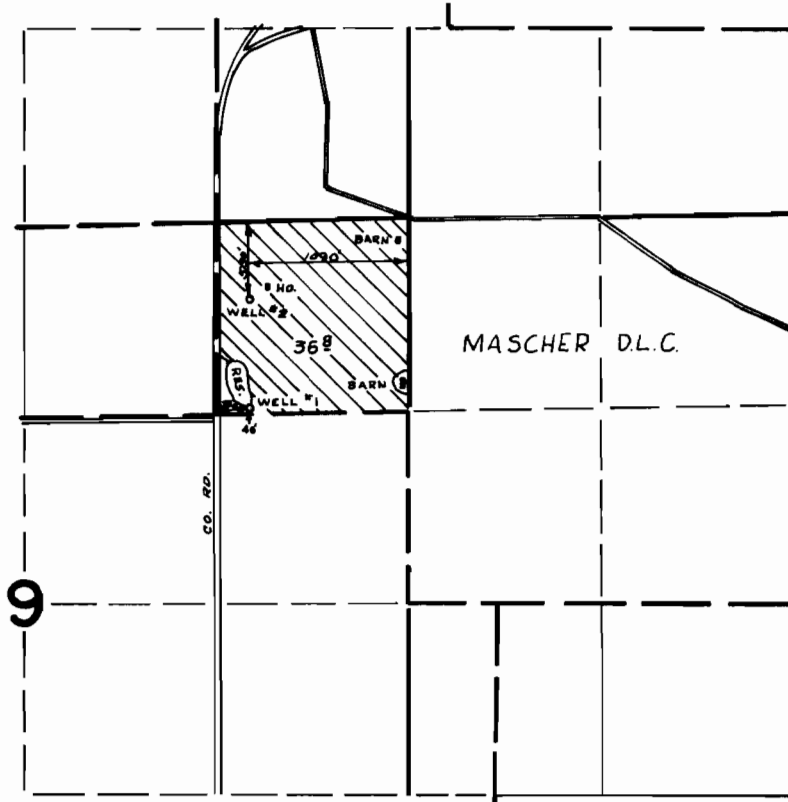

*Surveyed
S. T. 1972*

FINAL PROOF SURVEY UNDER

Application No. G-3627 Permit No. G-3410
IN NAME OF

OTTO B. STADELI

Surveyed APRIL 18 1972, by D. NORBY