


T.6S. R.1W.W.M.

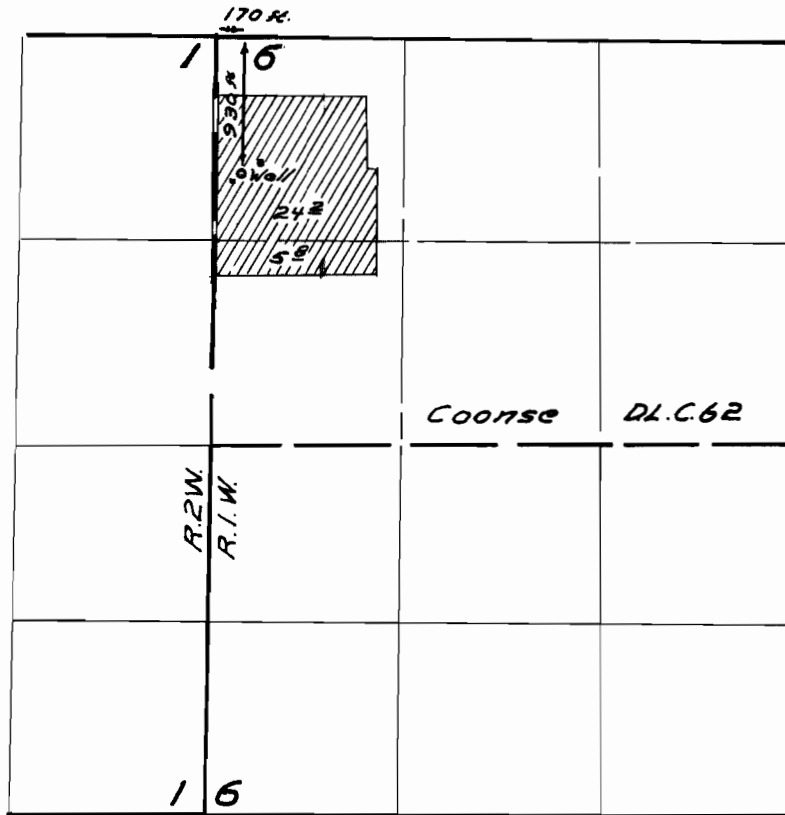

FINAL PROOF SURVEY UNDER

Application No. G-3238 Permit No. G-3043
IN NAME OF

M. F. & Rosemary Terhaar

Surveyed July 29 1966, by W.J. Ruppert