


T. 4 S. R. 1 W. W.M.

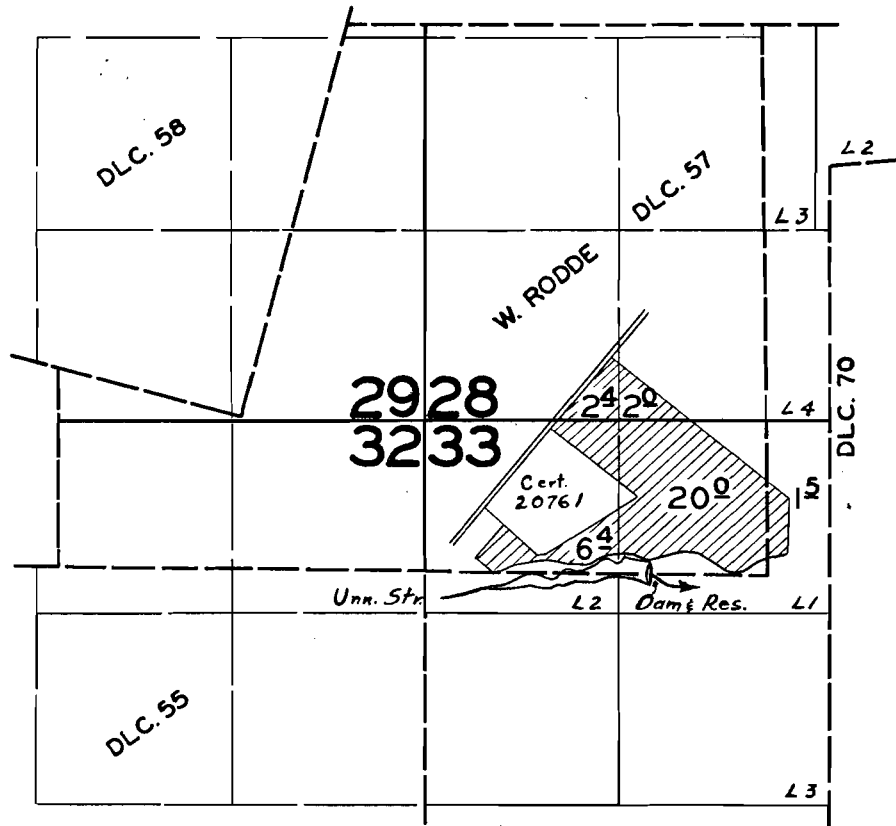

FINAL PROOF SURVEY

UNDER

R-28723

R-1559

Application No. 28724 Permit No. 22610

IN NAME OF

ARTHUR R. ZEHNER

Surveyed MAR. 18, 1957, by C.O. BARTELS