


# T. 6 S. R. 1 W. W. M.

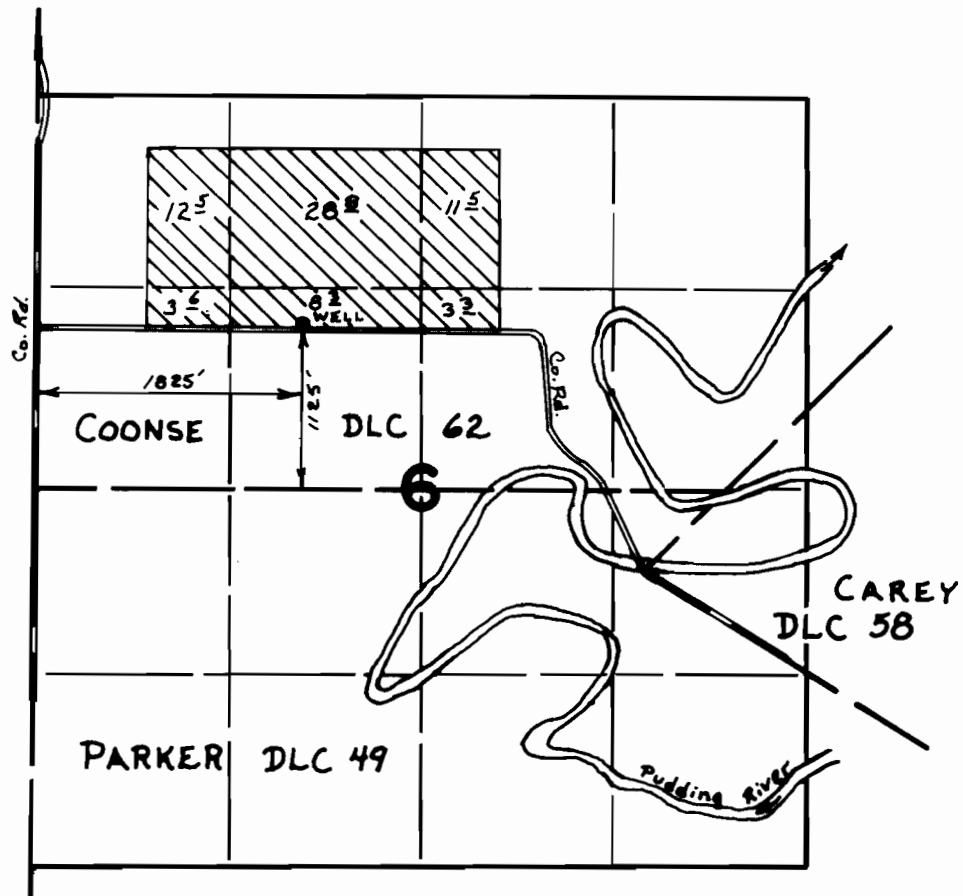

## FINAL PROOF SURVEY UNDER

Application No. G-5944 Permit No. G-5643  
IN NAME OF

ANDREW EDER

Surveyed June 1, 1977, by D. NORBY  
APR 26 1979 L. H. NUNN