


T. 4 S. R. 1 & 2 W. W. M.

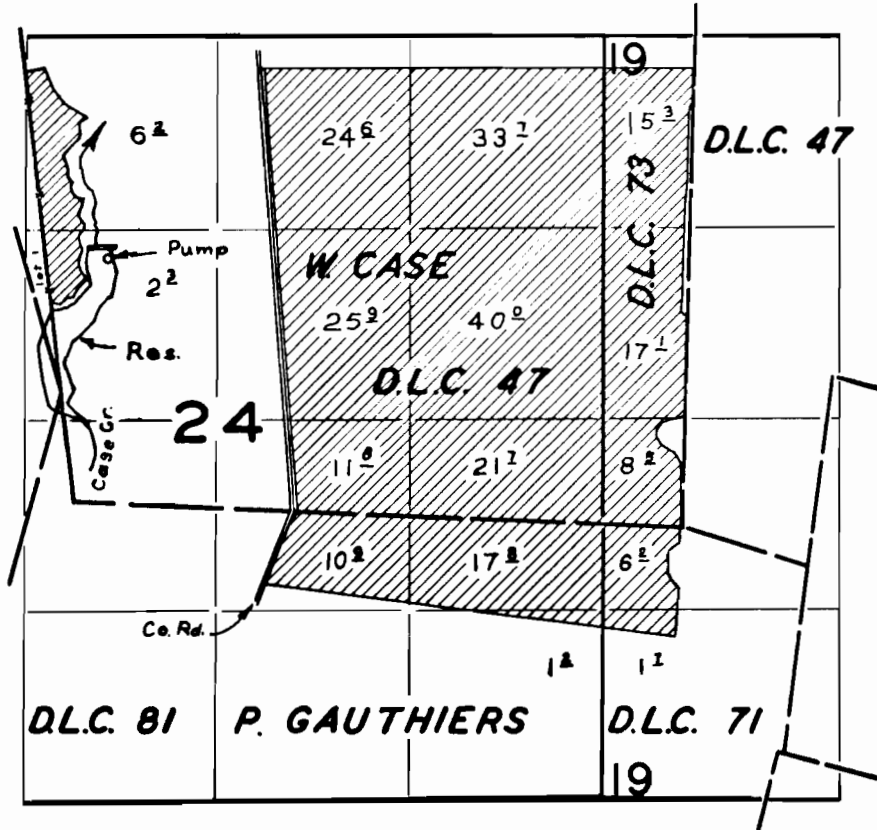

G 4965

G 4685

FINAL PROOF SURVEY
UNDER

Application No. 37811 Permit No. 28158
IN NAME OF

JOSEPH WILMES

Surveyed APR. 8 1964, by R. JACKSON