


# T.5S. R.2W., W.M.

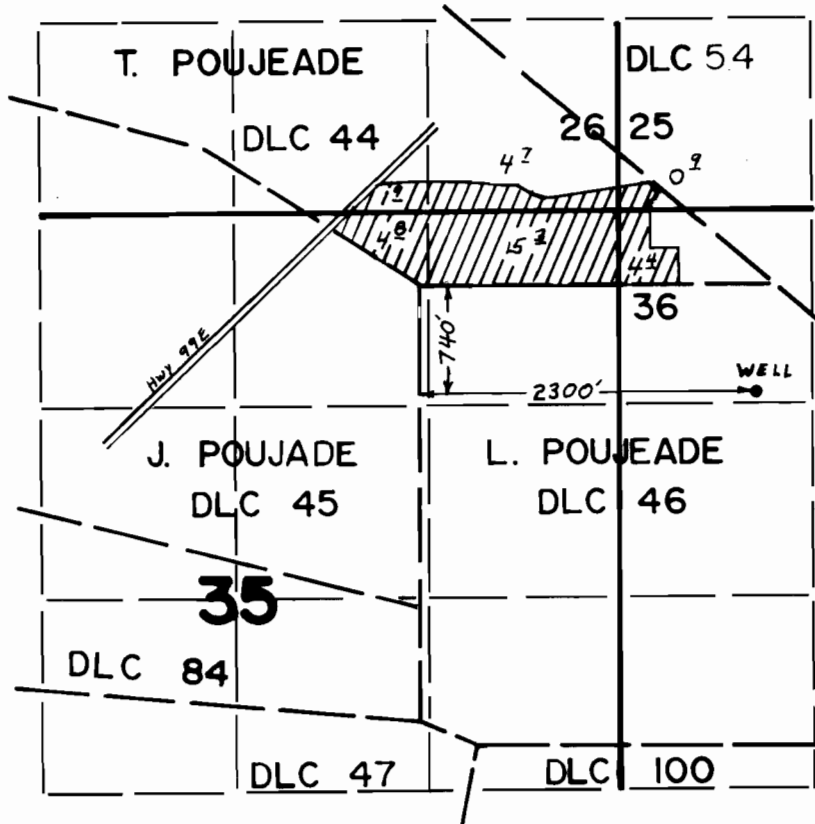

## FINAL PROOF SURVEY UNDER

Application No. G-6045.. Permit No. G-5721....  
IN NAME OF

.....JOHN T. WAVRA.....

Surveyed SEP. 28.. 1978., by S.P. APPLGATE