T.5S. R.1&2 W., W.M.

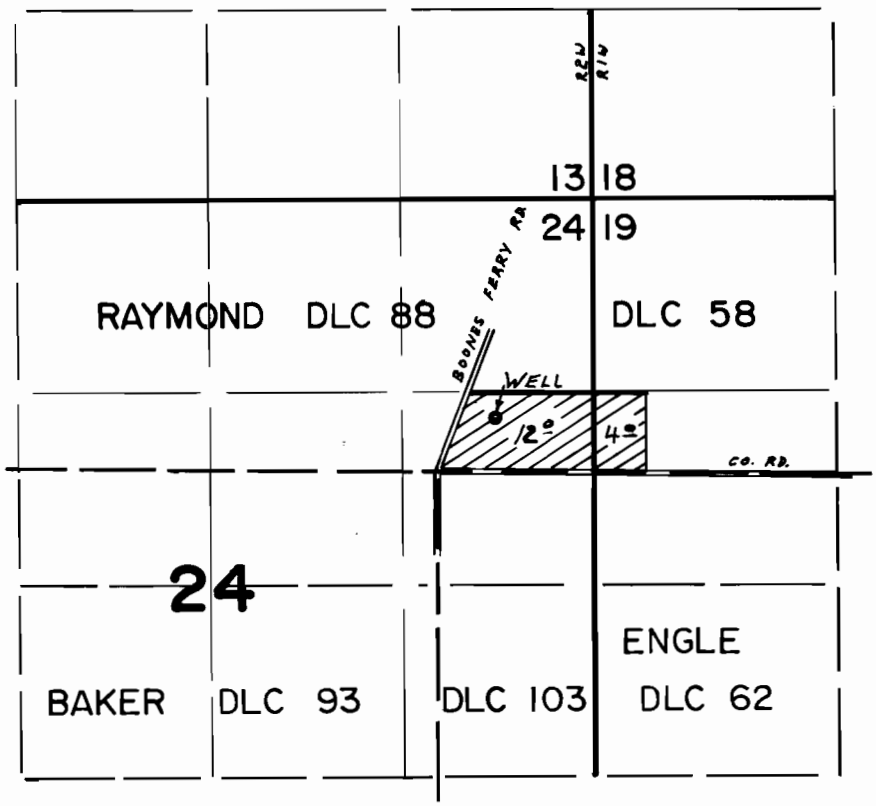

WELL LOC. 370'N. & 390'E. FROM N.E. COR. J. BAKER D.L.C. 93

FINAL PROOF SURVEY
UNDER

Application No. G-7919 Permit No. G-7311
IN NAME OF

D. L. SEELY

Surveyed SEP. 27 1978, by S.P. APPLEGATE

DFN-GLL-197 & 198