


G 2624

44822

T. 4N. R. 28&29E. W.M.

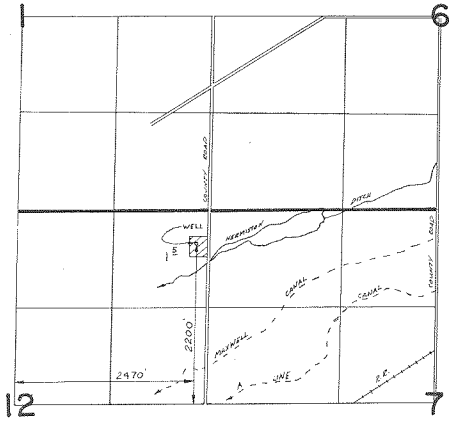

**FINAL PROOF SURVEY
UNDER**

Application No. G-2821 Permit No. G-2624
IN NAME OF

FRANCIS F. BOWMAN

Surveyed 6-29 1979, by V. CHURCH