


P# 2488

T.2N. R.14E. W.M.

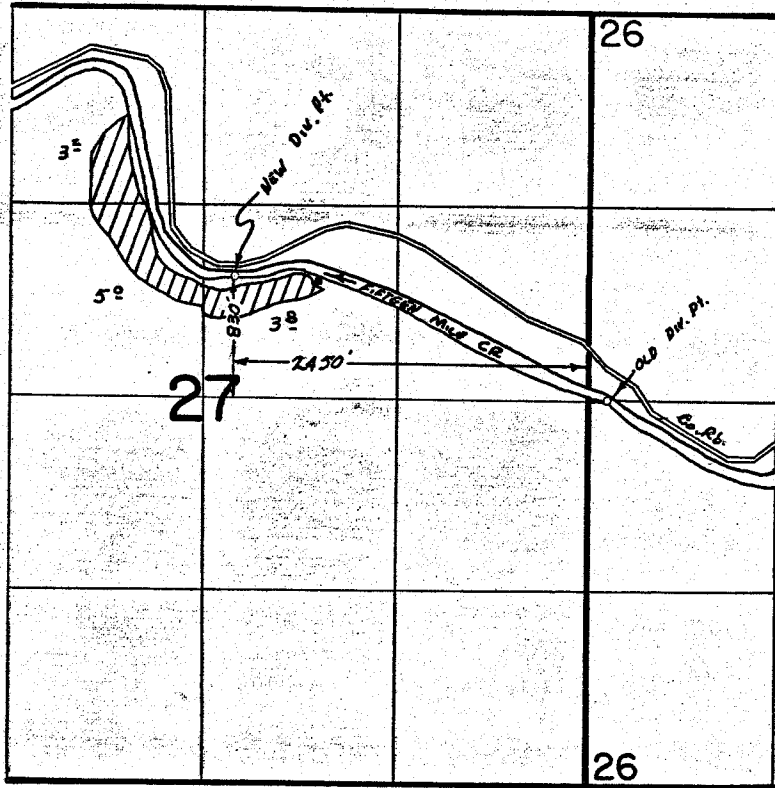

APPLICATION MAP FOR
CARL KASER

Scale 4" = 1 mile

RECEIVED
MAY 19 1977
WATER RESOURCES DEPT
SALEM, OREGON

Application Map Prepared By
Watermaster District No. 3
Thomas J. Paul