


T2N-R14E, W.M.

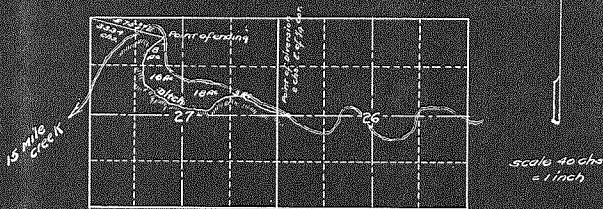

I, Floyd G. Betts, of The Dalles, Oregon do hereby certify that this map was made from notes taken during an actual survey made by me on the 15th day of May 1916, and that it represents the location of the ditch, together with the location of 15 Mile creek, and has written thereon the area in each smallest legal subdivisions which it is proposed to irrigate.

Floyd G. Betts
Surveyor

This is map of entire right. Portion is covered by Cert. 49825 after change in POINT OF DIVERSION.