


T9S. R27E. WM.

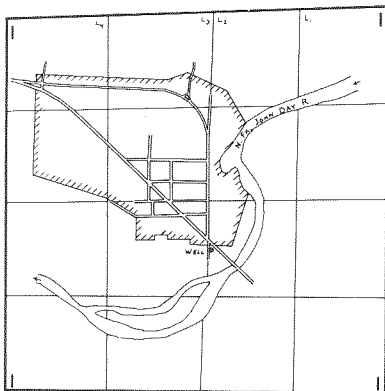

WELL LOC: 670'S. 1 50'E. fr. C. 1/4 COR. SEC. 1

 SERVICE AREA BOUNDARY

FINAL PROOF SURVEY

UNDER

Application No. **G-7165** Permit No. **G-6734**.....
IN NAME OF

CITY OF MONUMENT

Surveyed Oct. 13, 1977, by S. C. BROWN