


T.2N.,R.12E.,WM.

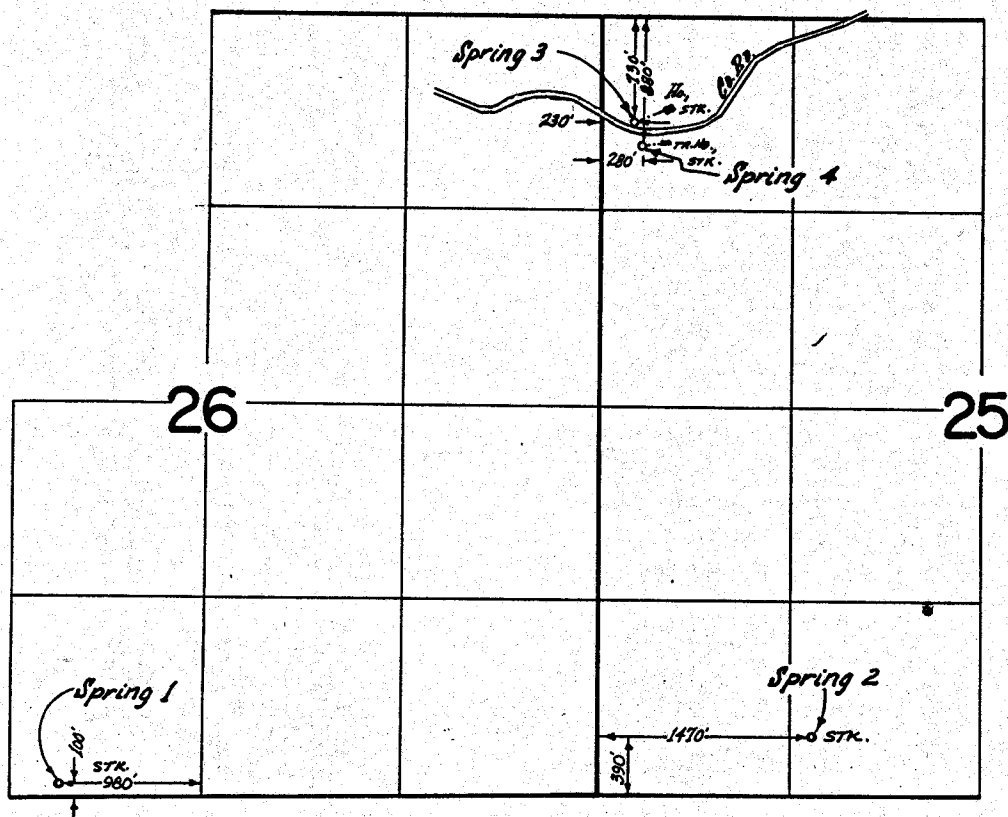

FINAL PROOF SURVEY
UNDER

Application No. 48570 Permit No. 36450
IN NAME OF

KENNETH I. & VIOLET M. SAUTER

Surveyed June 29 1977, by R. G. Muckan