


# T.2S.R.2W. W.M.

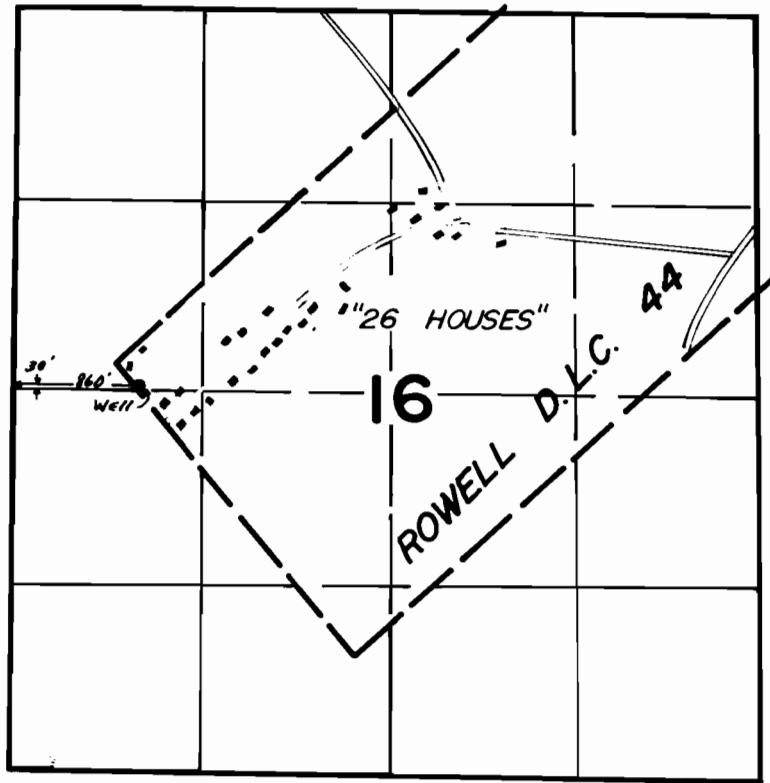

## FINAL PROOF SURVEY UNDER

Application No. G-7278. Permit No. G-6741...  
IN NAME OF

WOLSBORN FARMS WATER DIST...

Surveyed July...25. 1978., by R.G.Mucken.....