


T.14S. R.7 & 8W. W.M.

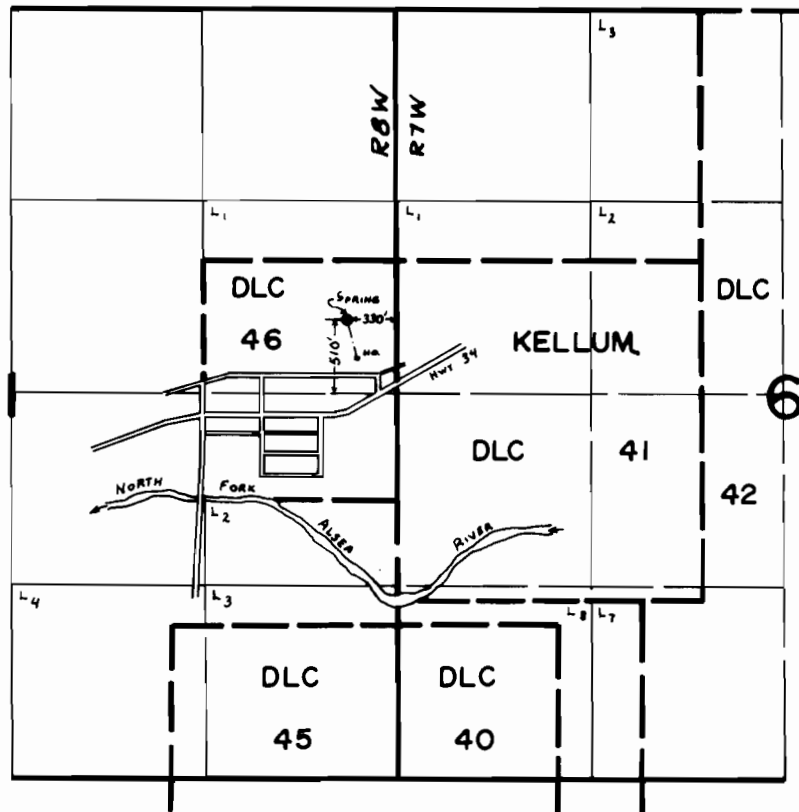

FINAL PROOF SURVEY
UNDER

Application No. 49307 Permit No. 36969
IN NAME OF

Everett R. Hearing

Surveyed May 20 1980, by C. L. Hughes