


T. 5 S., R. 1 E., W. M.

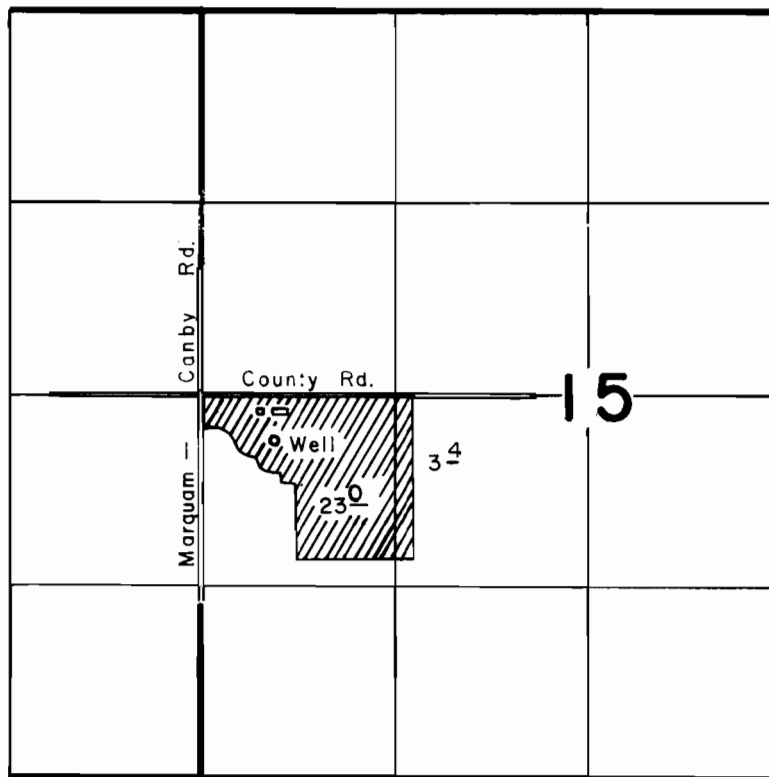

Well located 300' S. & 500' E. from NW corner SW 1/4 section 15

**FINAL PROOF SURVEY
UNDER**

Application No. G-6565 Permit No. G-6166
IN NAME OF

HAROLD E. & ODELLA M. CONKLING

Surveyed MAY 1, 1978, by J. S. DONALDSON