


T. 29 S., R. 5 W., W. M.

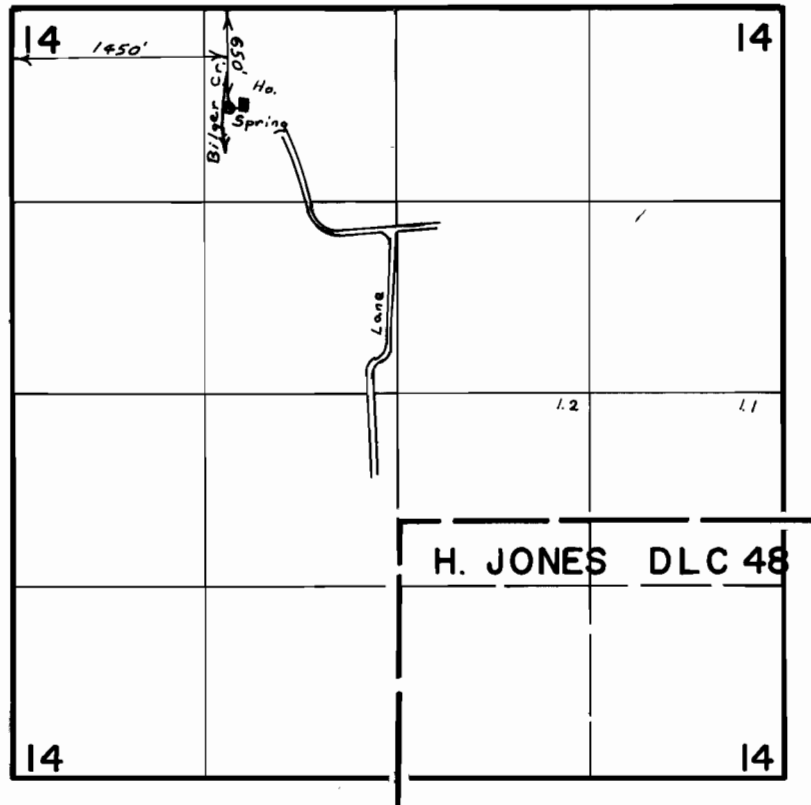

SCALE 4"=1 mile

FINAL PROOF SURVEY UNDER

Application No. 51107... Permit No. 38556.
IN NAME OF

Riley H. & Irah M. Haque

Surveyed Dec. 12, 1979, by S. Donaldson.