


T. 25 S., R. 7 W., W.M.

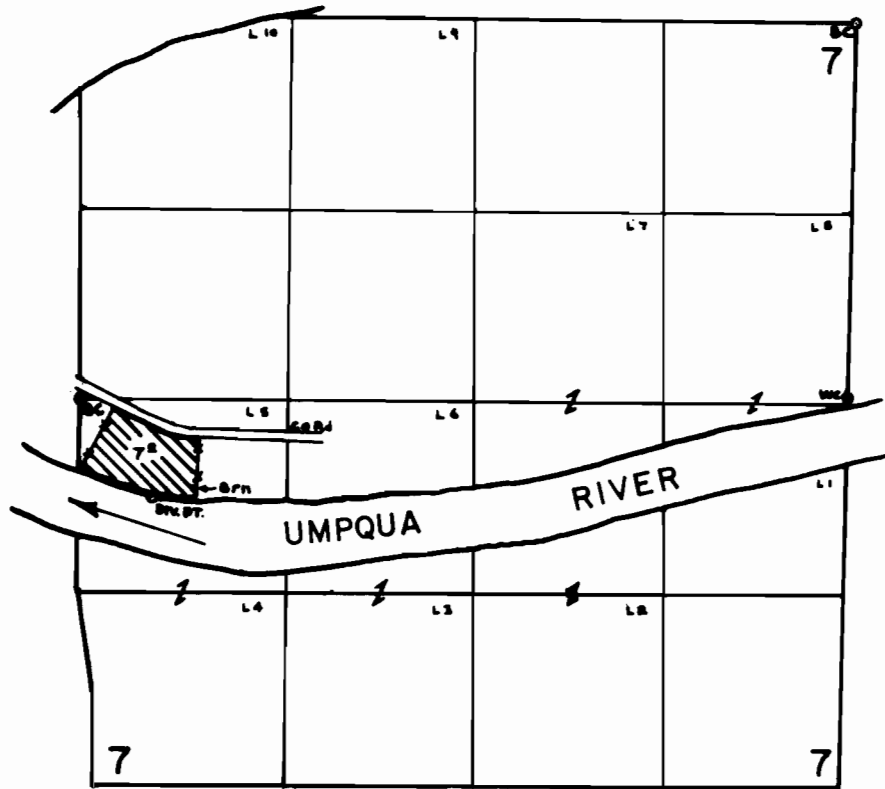

DIV. PT. LOC. 675'S. & 500'E FROM THE W. 1/4 COR. SEC. 7

FINAL PROOF SURVEY
UNDER

Application No. 48616 Permit No. 36469
IN NAME OF

HAROLD EDWIN HATCHER

Surveyed NOV. 2 1977, by D. W. SPARKS