
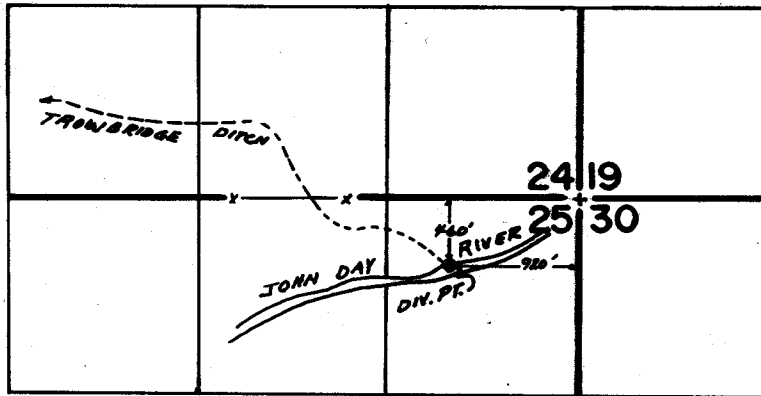


# T. 13S. R. 31E. W.M.

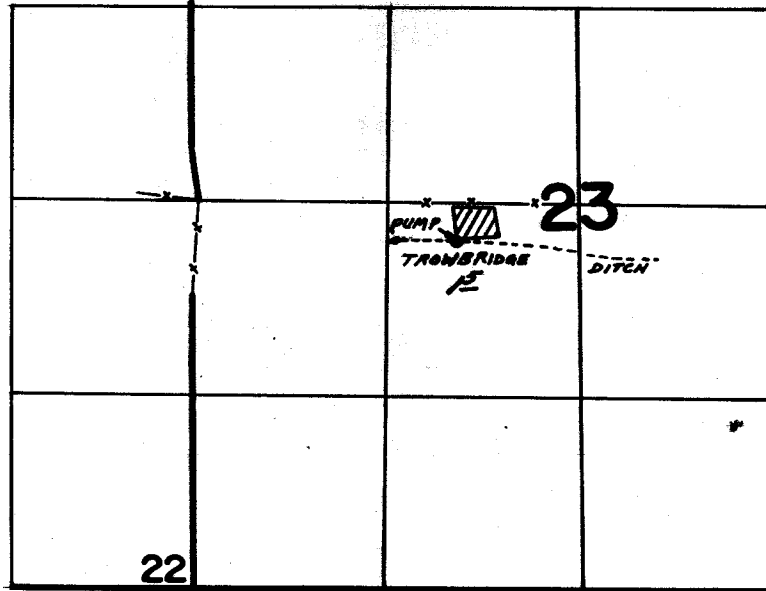

## FINAL PROOF SURVEY UNDER

Application No. 55151..... Permit No. 41457.....  
IN NAME OF

.....DON ILER.....

Surveyed June 8..... 1978., by J.S. Donaldson...