


T. 35 S., R. 7 W., W.M.

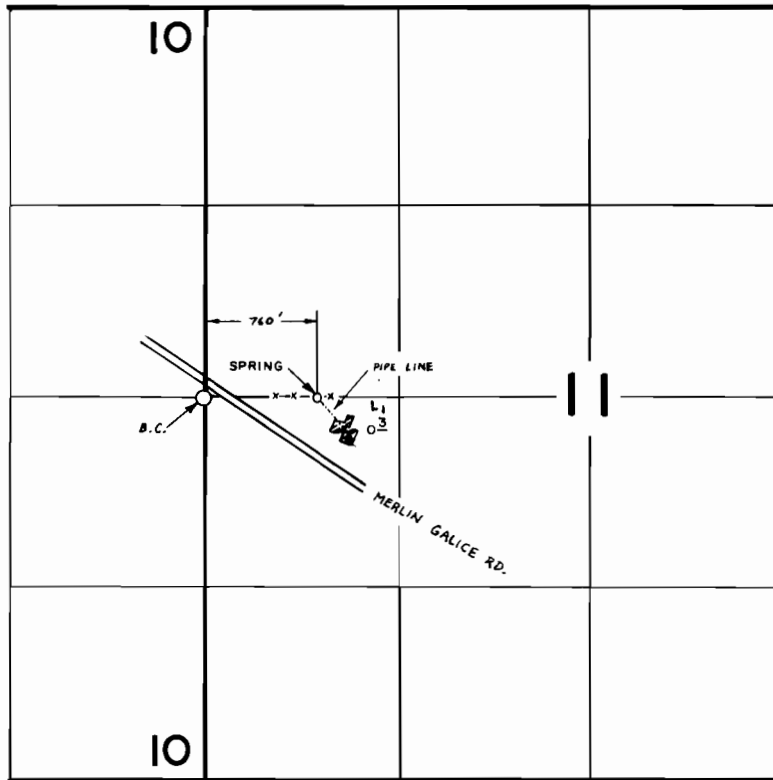

FINAL PROOF SURVEY
UNDER

Application No. 48387 Permit No. 36325
IN NAME OF

GORDON T. FURMIDGE

Surveyed SEPT. 30 1977, by B. SUND