


ms

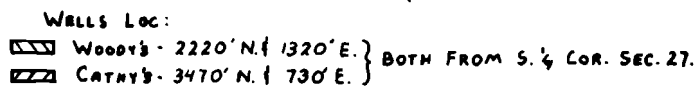

Application No. **G-7272** Permit No. **G-6682**
IN NAME OF

Surveyed Aug. 29, 1979, by C. L. HUGHES

PTS-1979-K