



T. 28 S. R. 14 & 15 E. W.M.

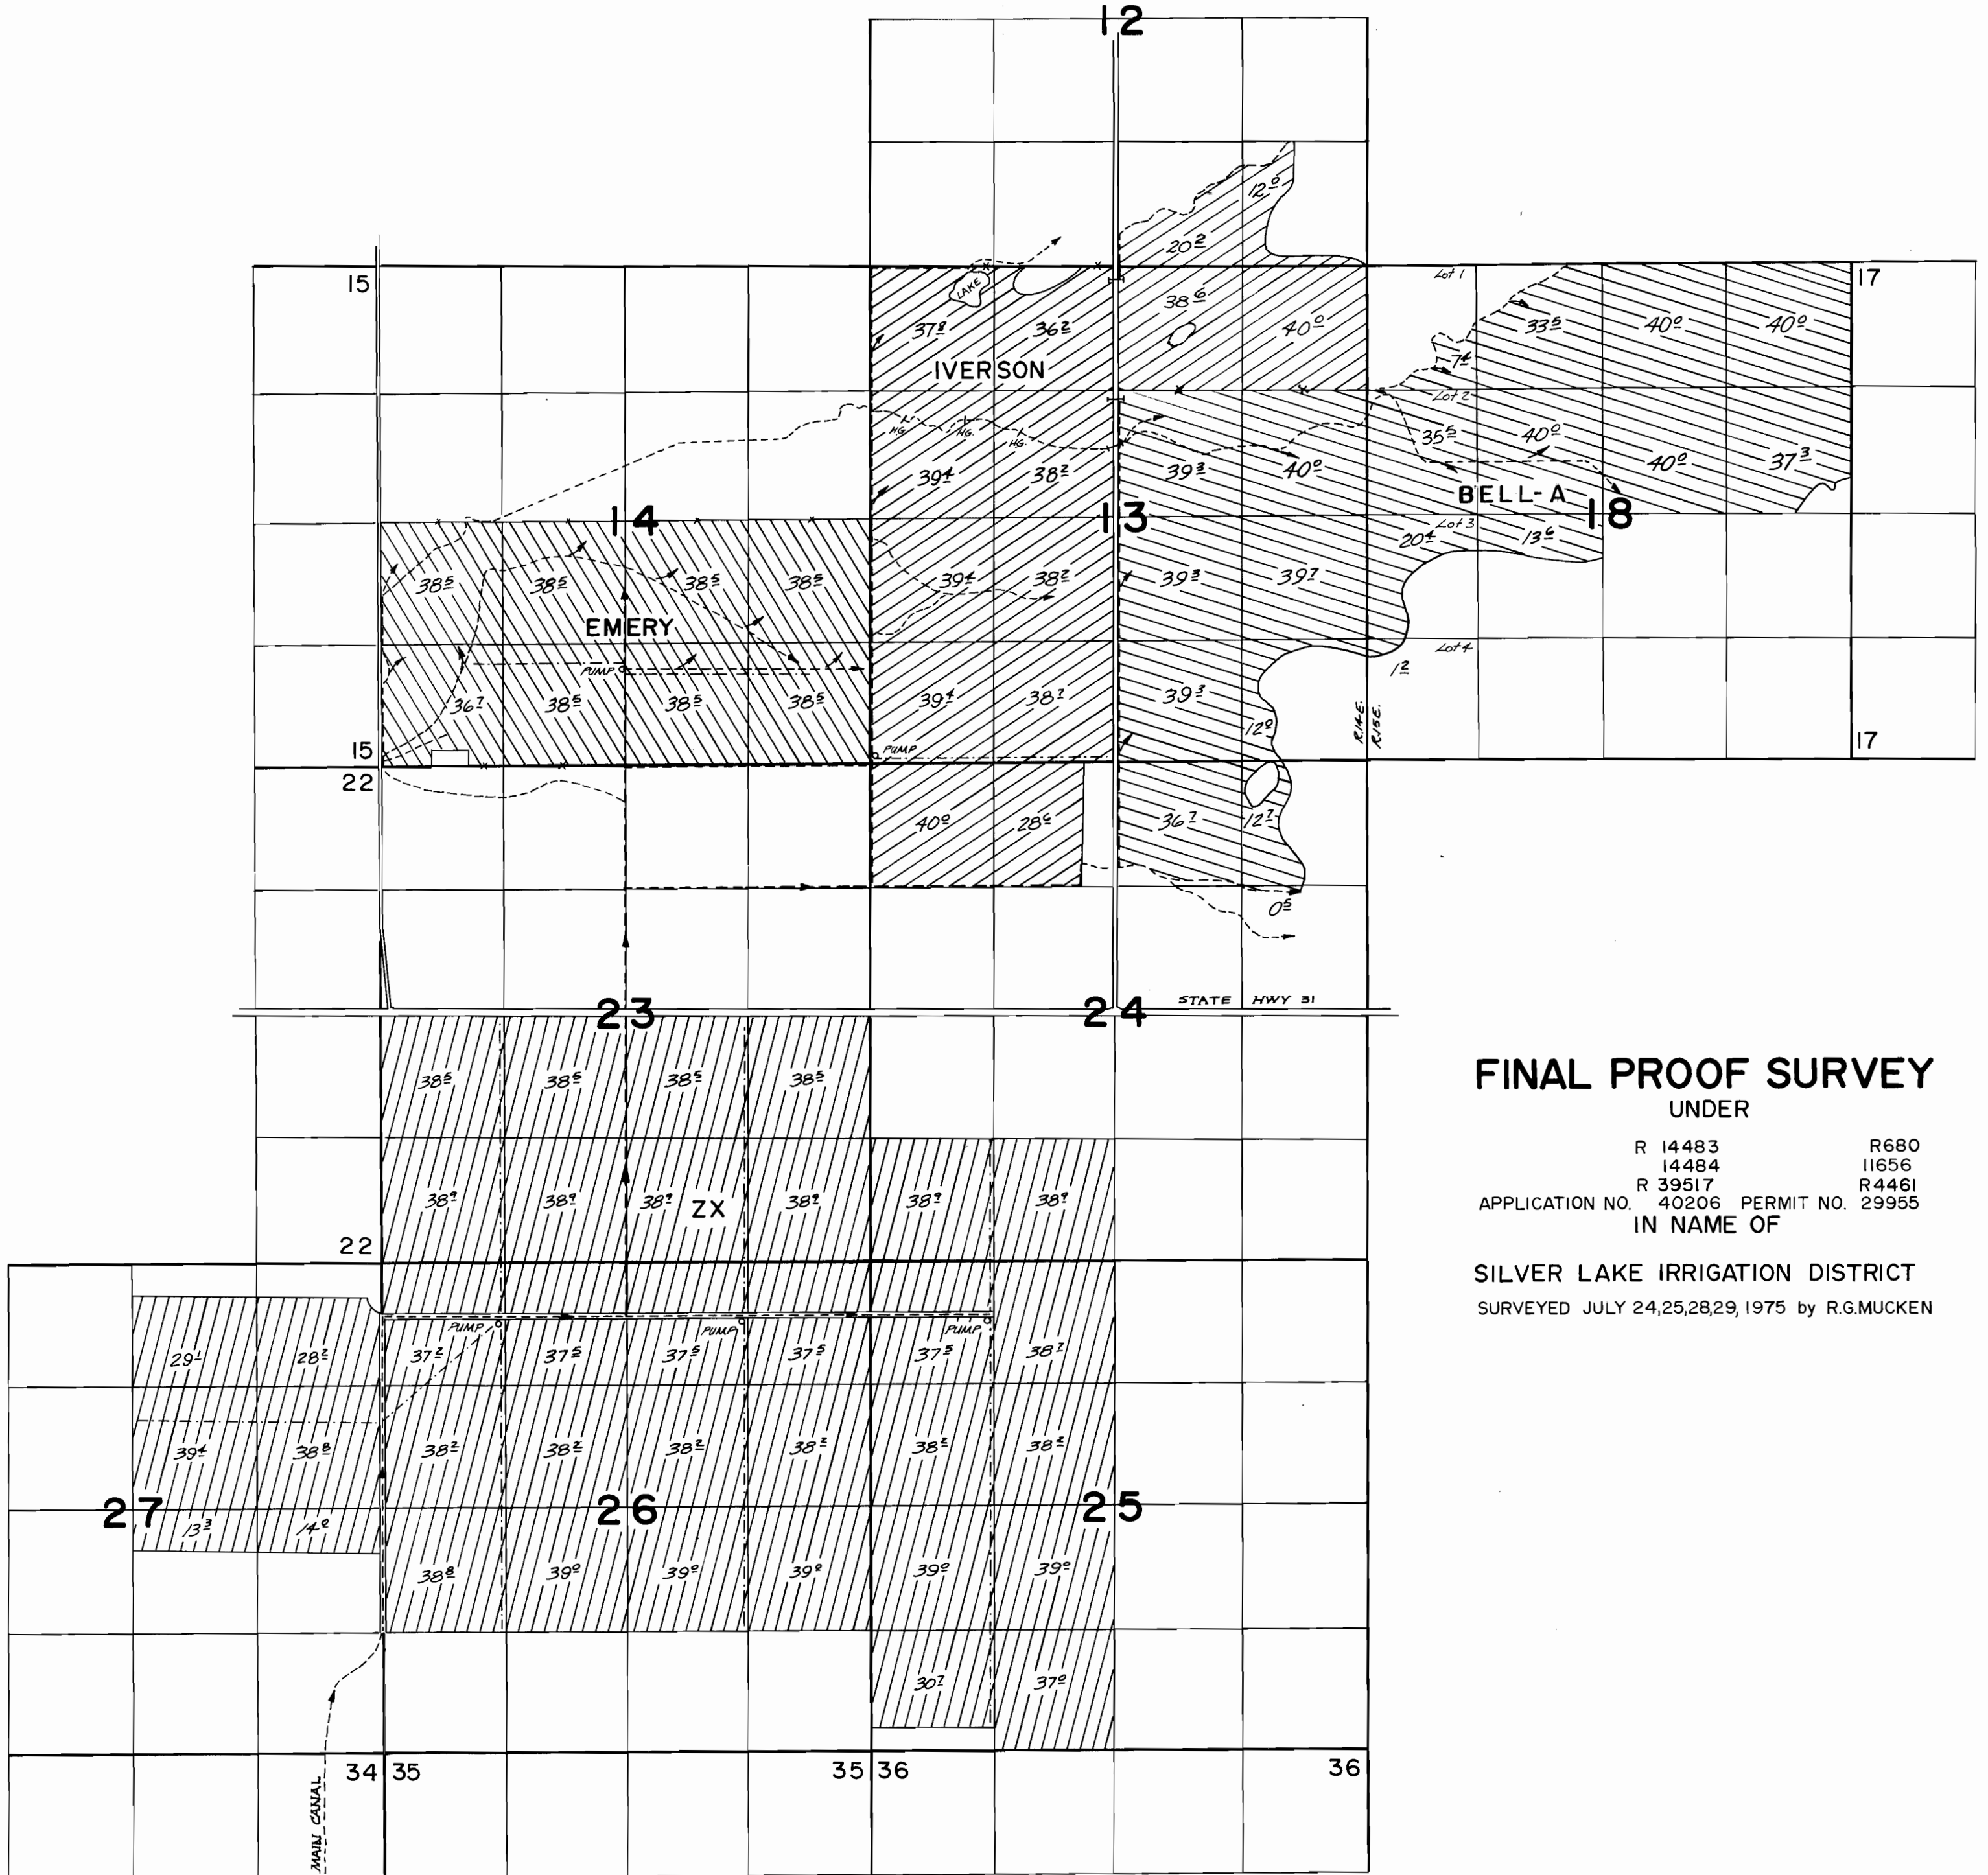

**FINAL PROOF SURVEY**  
UNDER

R 14483 R680  
14484 11656  
R 39517 R4461  
APPLICATION NO. 40206 PERMIT NO. 29955  
IN NAME OF

SILVER LAKE IRRIGATION DISTRICT  
SURVEYED JULY 24,25,28,29,1975 by R.G.MUCKEN

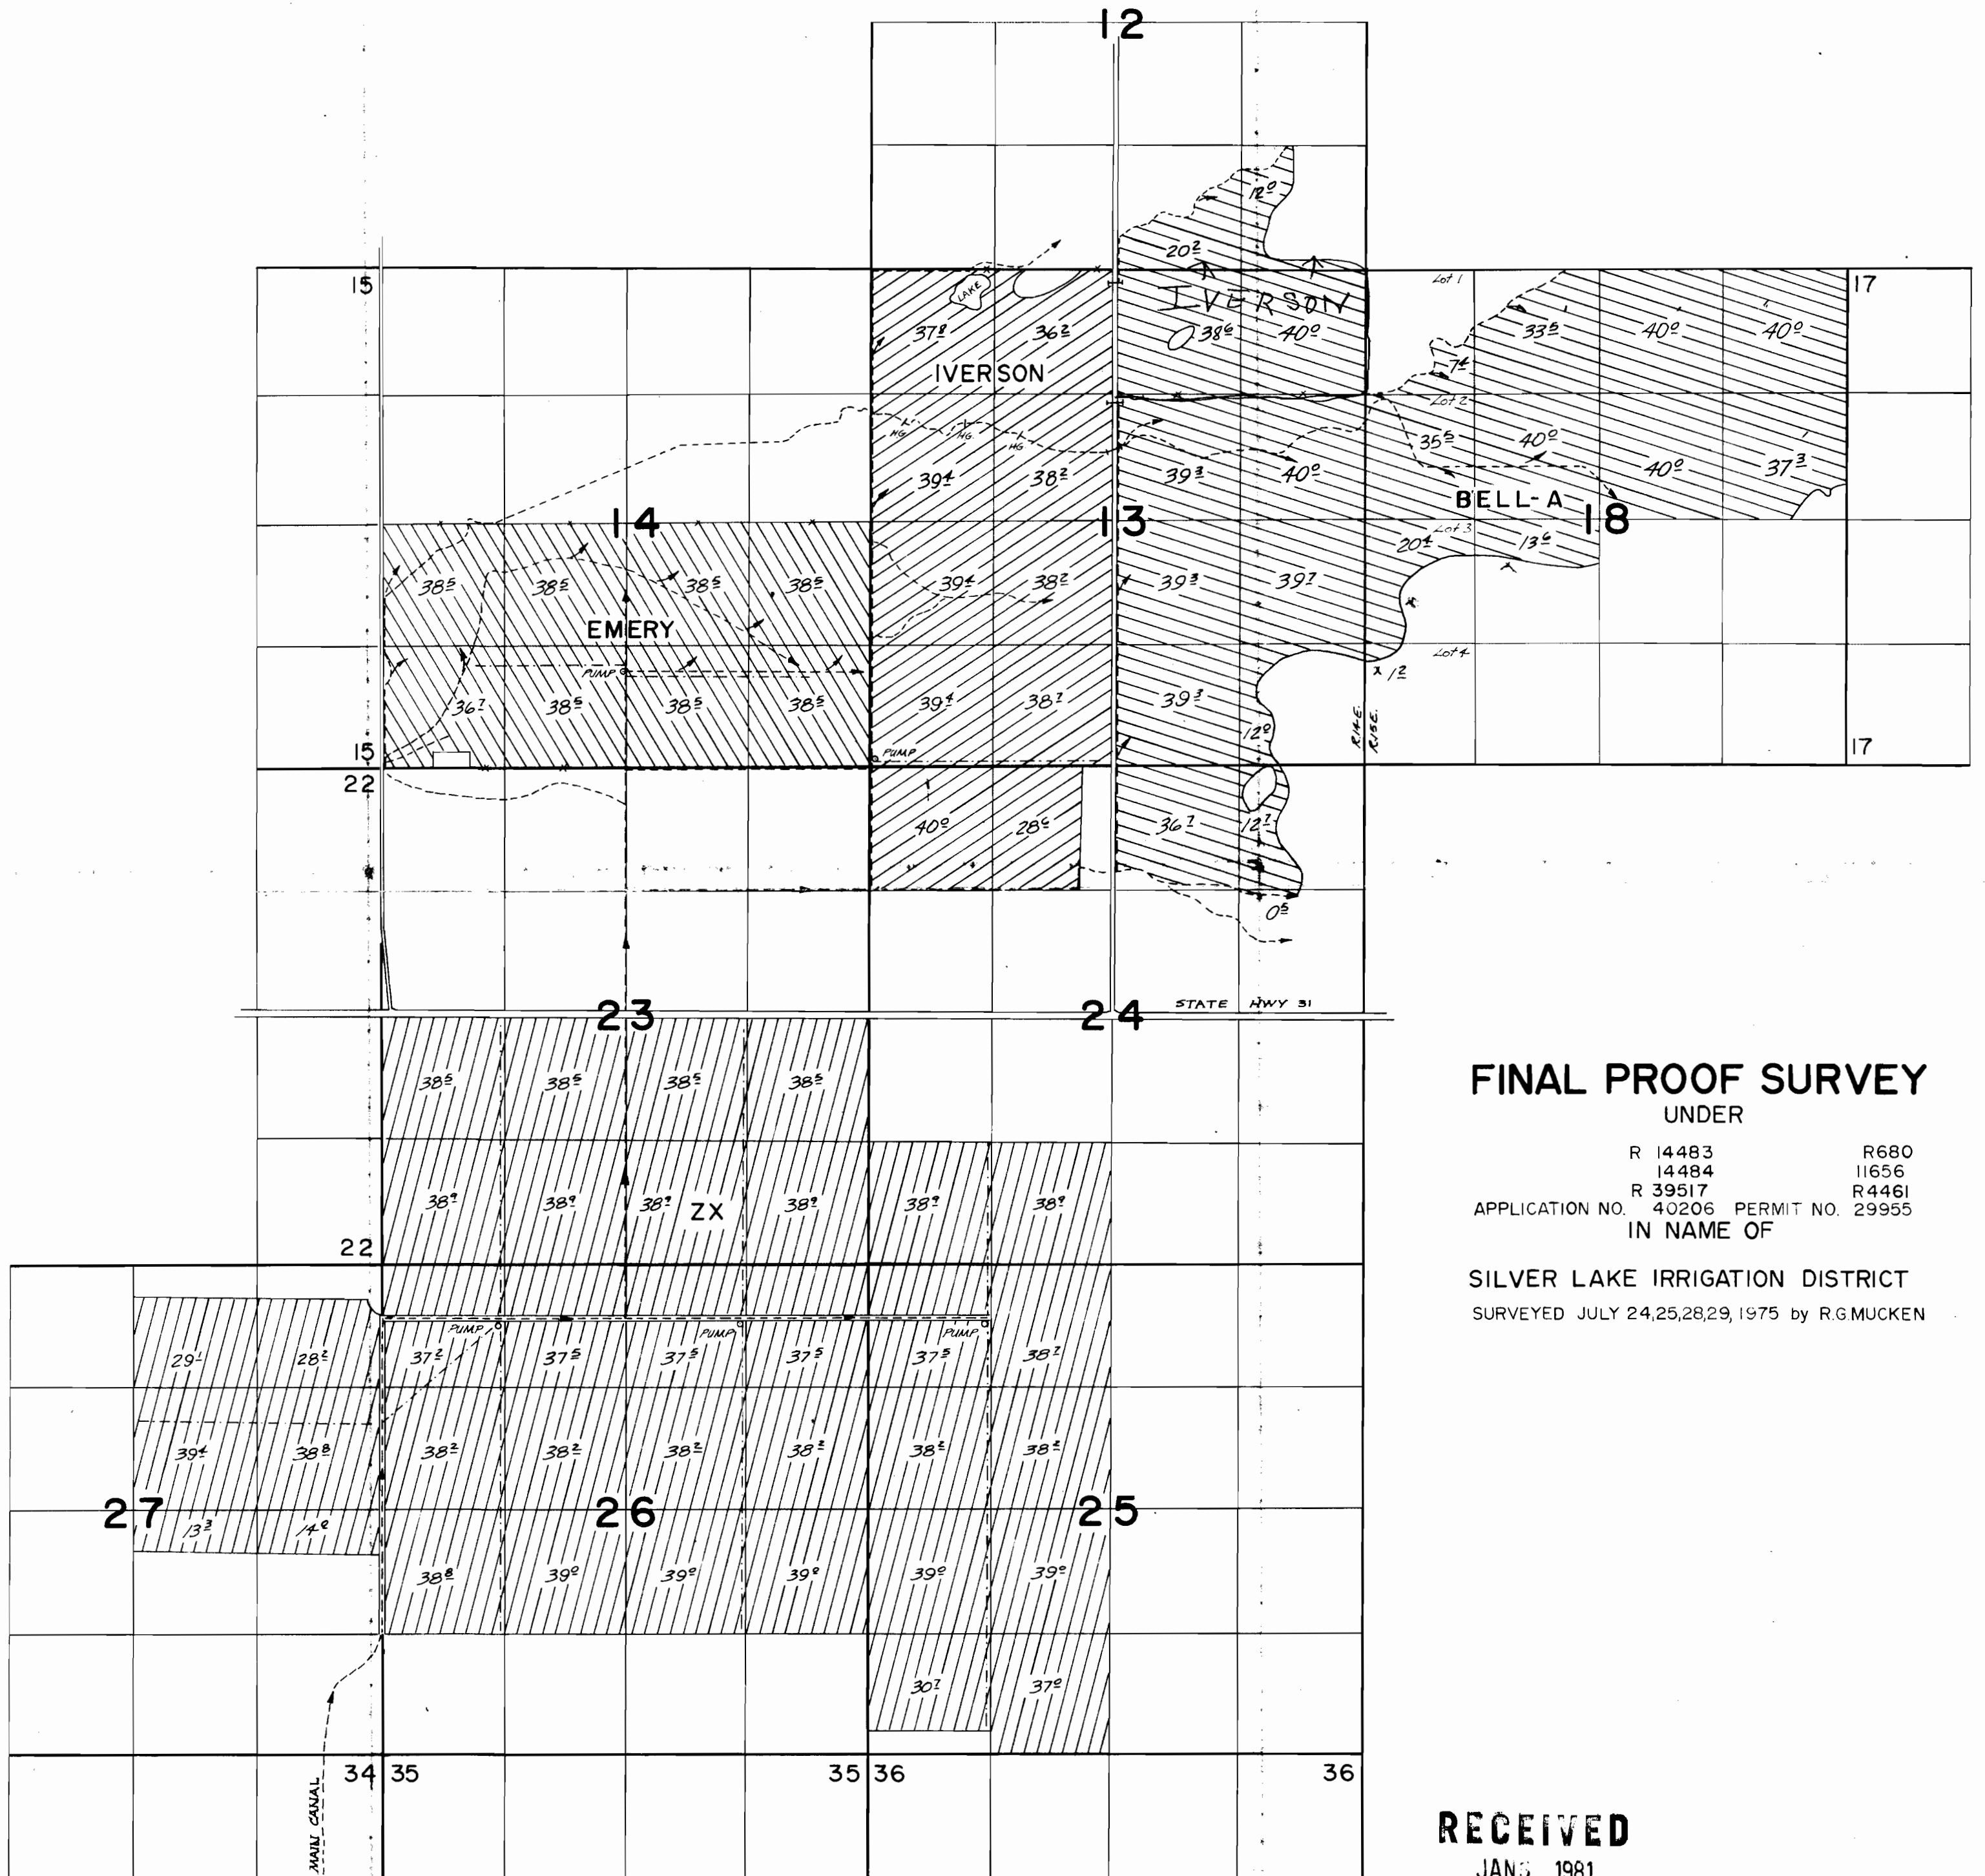

**FINAL PROOF SURVEY**

UNDER

R 14483 R680  
 14484 11656  
 R 39517 R4461  
 APPLICATION NO. 40206 PERMIT NO. 29955  
 IN NAME OF

SILVER LAKE IRRIGATION DISTRICT  
 SURVEYED JULY 24,25,28,29, 1975 by R.G.MUCKEN

**RECEIVED**

JAN 5 1981

WATER RESOURCES DEPT.  
 SALEM, OREGON