


# T.18S. R.2W., W.M.

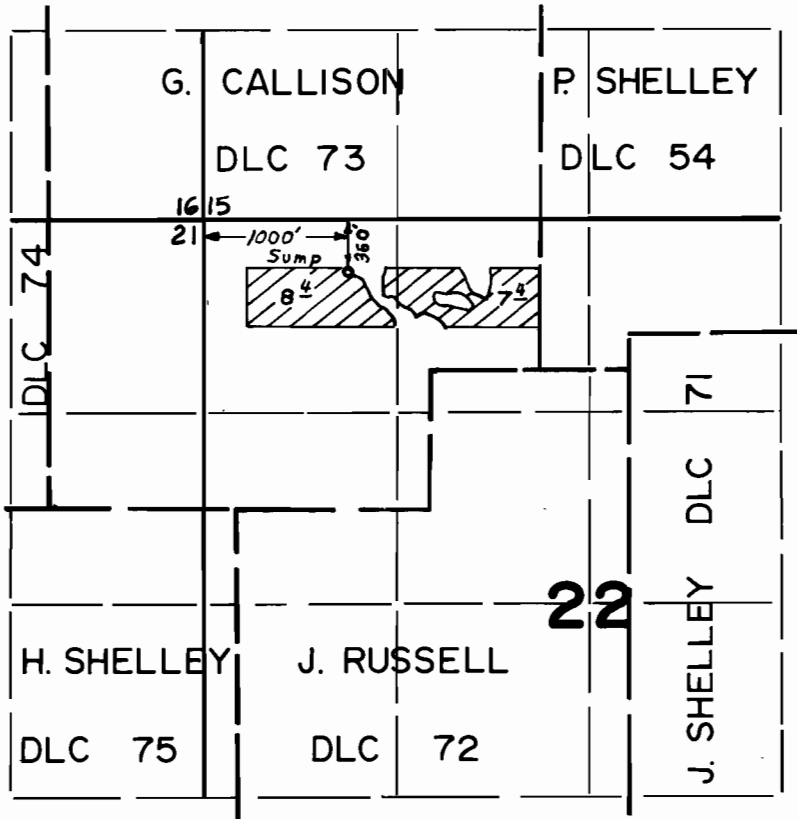

## FINAL PROOF SURVEY UNDER

Application No. G-6417... Permit No. G-5996...  
IN NAME OF

.....DONALD A. DICKISON.....

Surveyed MAY 18, 1978, by J. S. DONALDSON