


T.16S. R.8W., W.M.

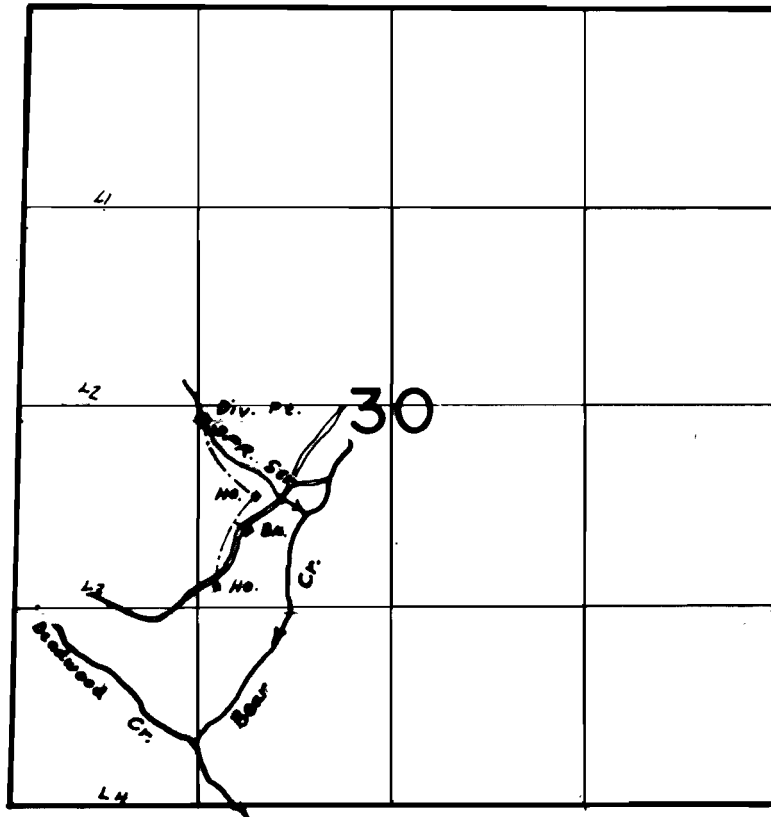

Div. Pt. Loc. 2650' N. & 1300' E. From S.W. Cor. Sec. 30

FINAL PROOF SURVEY UNDER

Application No. 55027... Permit No. 41221...
IN NAME OF

CLAIRE DOUGLAS

Surveyed SEP. 14, 1978, by S.P. APPLGATE