


# T.9&10S. R.3W., W.M.

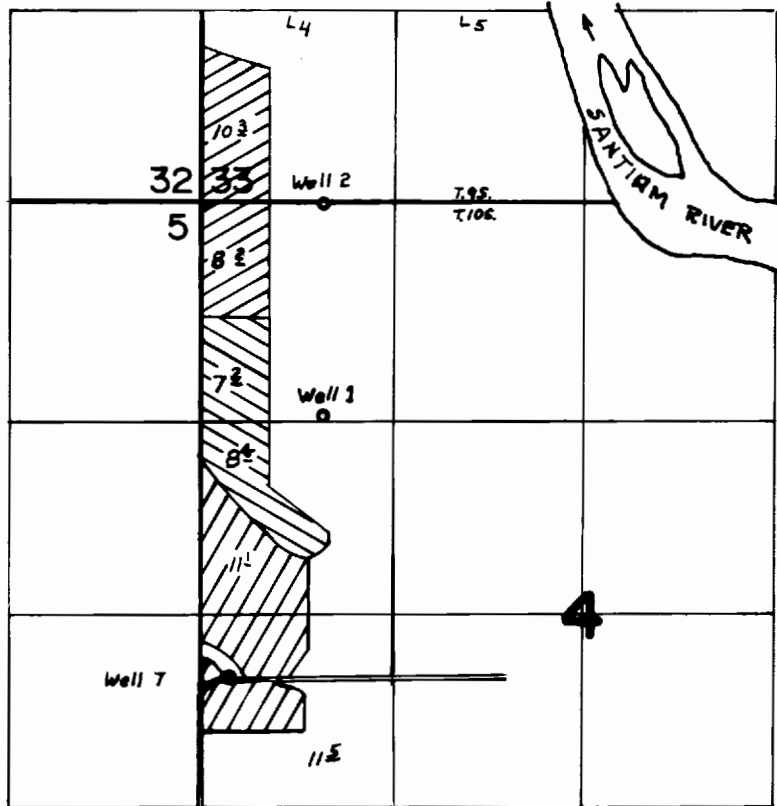

Wells Loc. : 1 - 1460'S. & 800'E. ; 2 - 20'S. & 800'E. ;  
 7 - 3260 S. & 190'E. All From N.W. Cor. Sec. 4

-  Well 1
-  Well 2
-  Well 7

## FINAL PROOF SURVEY UNDER

Application No. G-7533. Permit No. G-7005.  
 IN NAME OF

DEE S. CHAMBERS

Surveyed APR. 19. 1978., by S.P. APPLGATE