


# T. 10S. R. 2W., W.M.

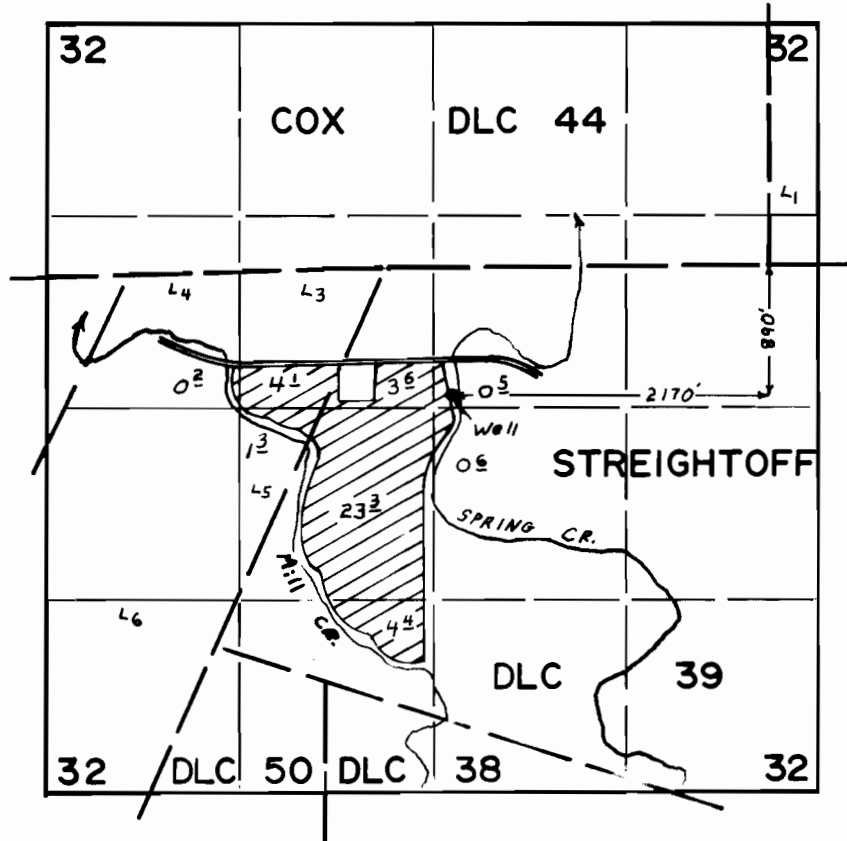

## FINAL PROOF SURVEY UNDER

Application No. G-5476. Permit No. G-5382...  
IN NAME OF

PLAGMANN FARMS INC.

Surveyed APR. 18. 1978., by S. P. APPLGATE