


T.11S., R.2W., W.M.

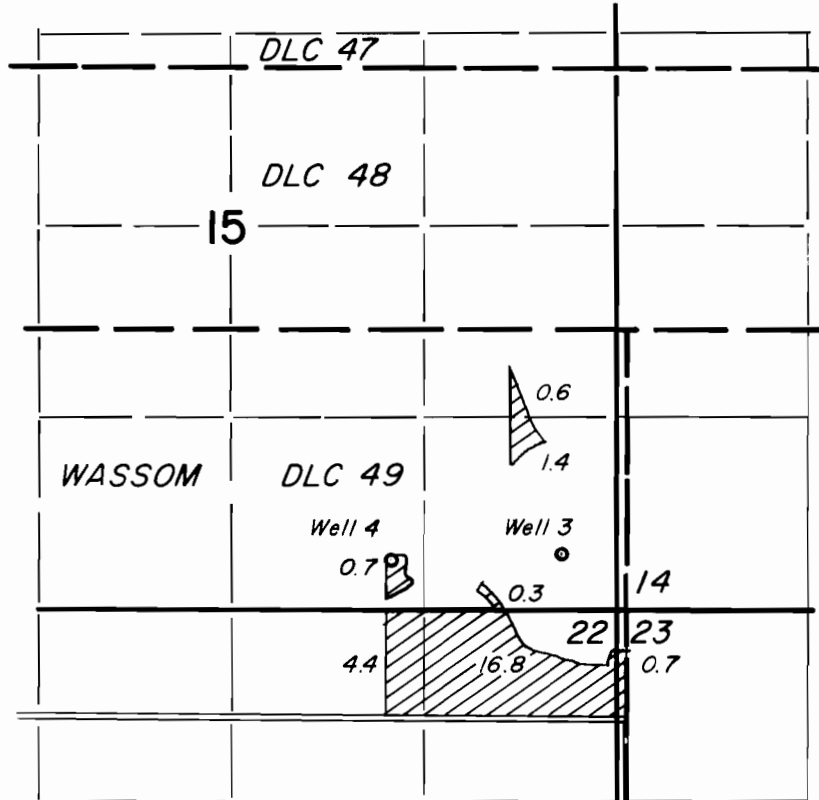

Wells Loc.: #3 - 1530 'S. & 450 'W.; #4 - 1530 'S. & 1630 'W. from the NE Cor DLC 49

FINAL PROOF SURVEY UNDER

Application No. G-7730 Permit No. G-6769

IN NAME OF

LOUREE CUNNINGHAM

Surveyed AUG. 8., 1977, by D. NORBY

JULY 6, 1979, S. BROWN