


T.9S. R.1W., W.M.

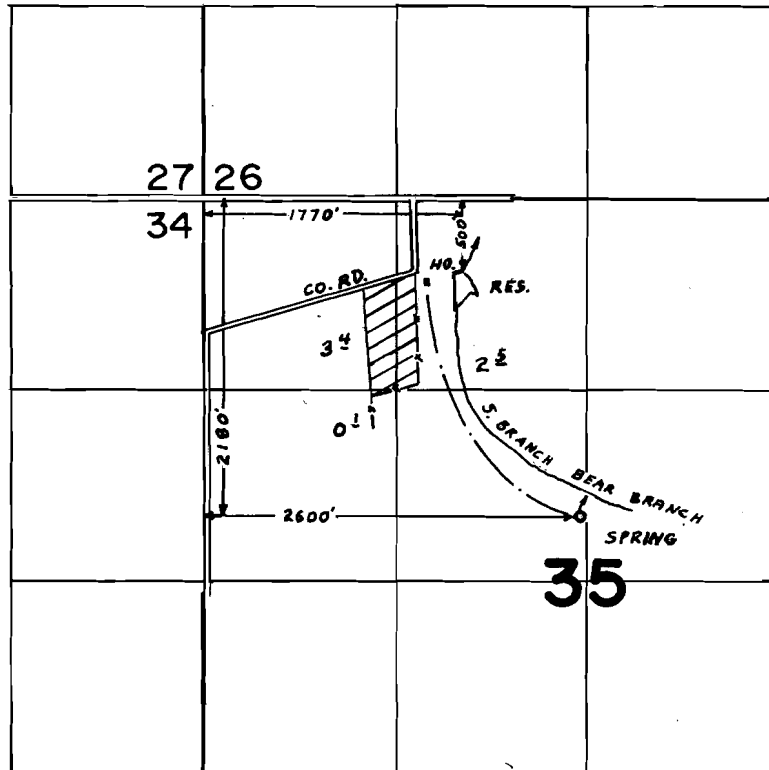

FINAL PROOF SURVEY
UNDER

R-48825 R-5922
Application No. 48826 Permit No. 36595
IN NAME OF

GENEVIEVE LACKNER & ESTATE OF ANTON LACKNER

Surveyed APR. 11, 1978, by S.P. APPLGATE