


# T.I.S., R.I.W., W.M.

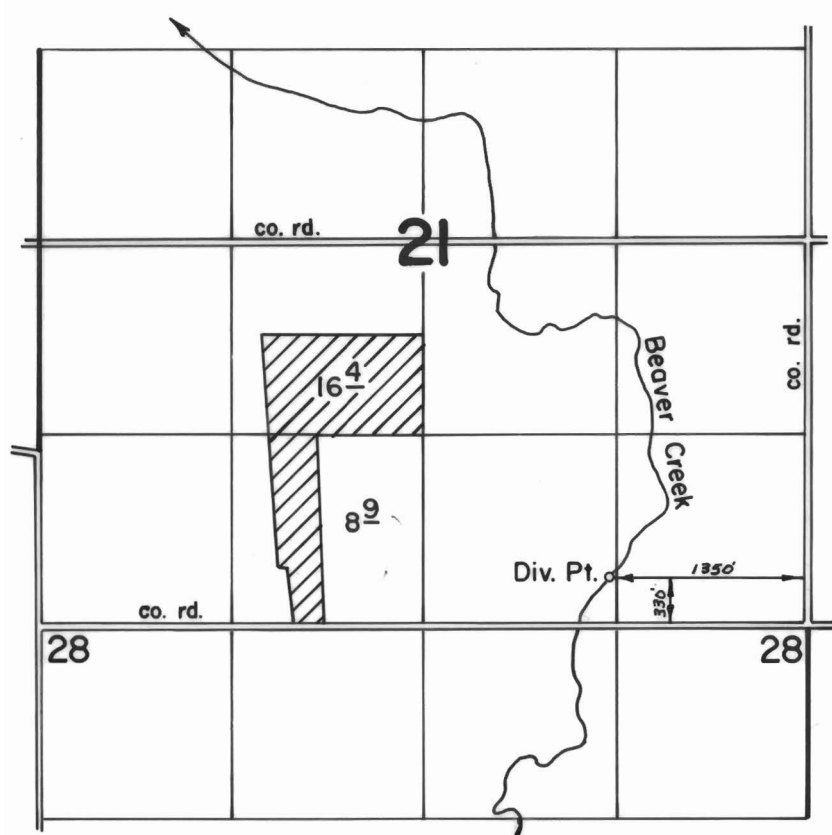

## FINAL PROOF SURVEY UNDER

Application No. 47289 Permit No. 35432  
IN NAME OF

DAVID & BEVERLY COEN

Surveyed Mar. 29 1976, by D. Norby