


T.4S.R.3W., W.M.

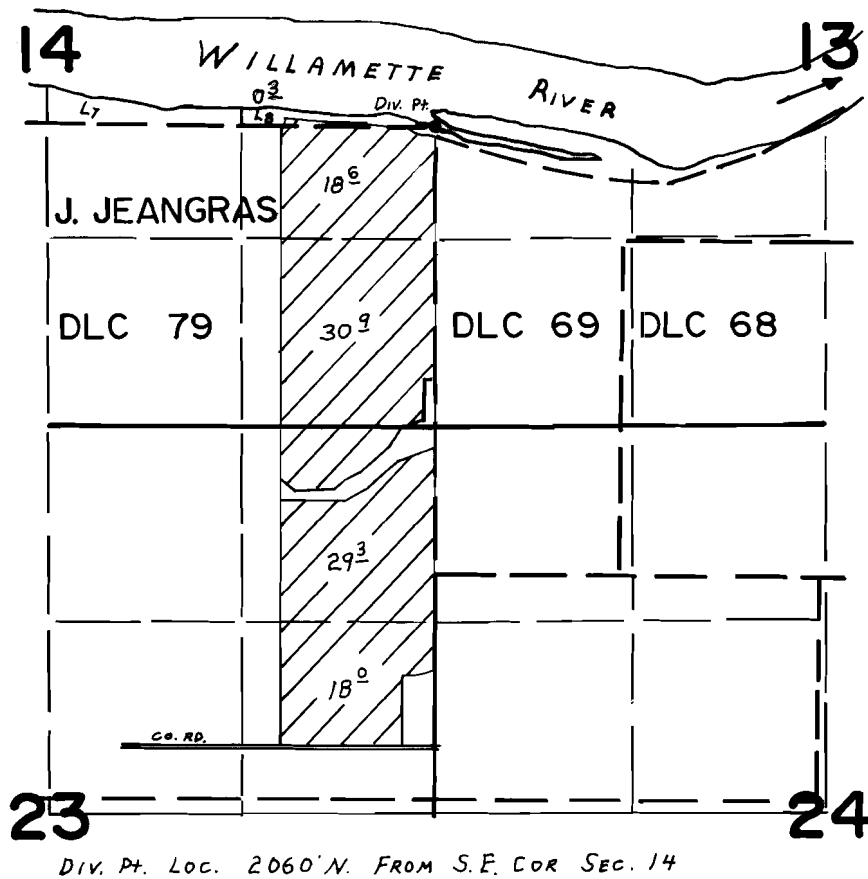

FINAL PROOF SURVEY
UNDER

Application No. 55307..... Permit No. 41484.....
IN NAME OF

.....DICK KIRK.....

Surveyed SEP. 26... 1978., by S.P. APPLGATE.