


T. 2 & 3S. R. 27 & 28E.
W. M.

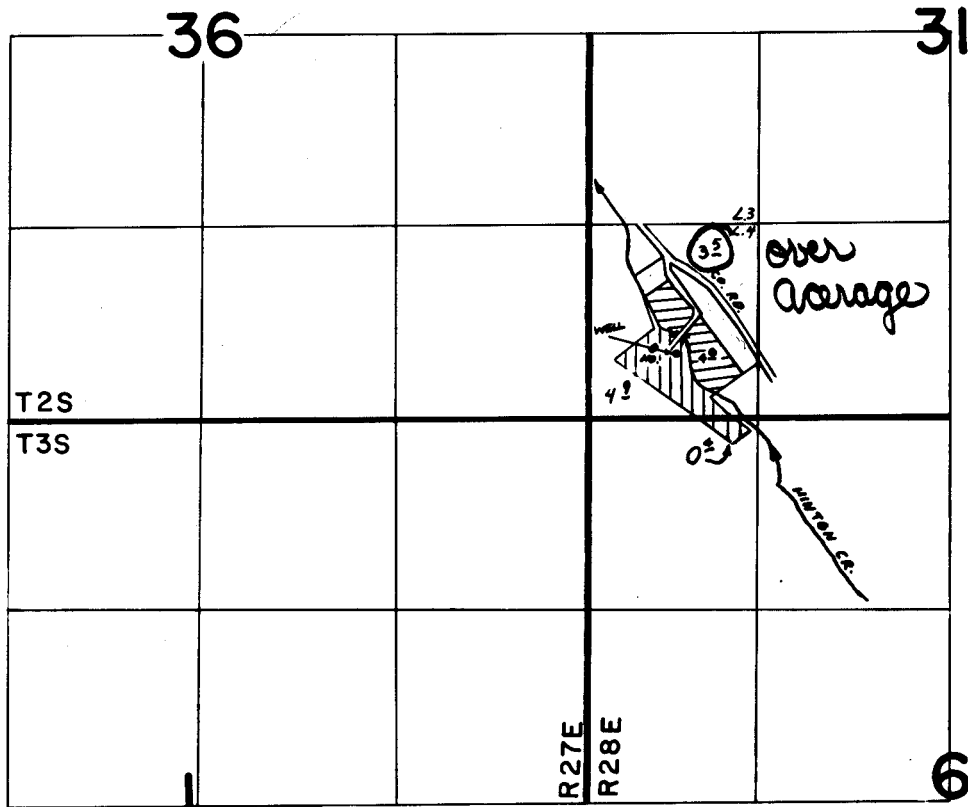

WELL LOCATED 440'N. & 600'E. FROM SW COR OF SEC 31



PRIMARY



SUPPLEMENTAL TO CERT. 234

FINAL PROOF SURVEY
UNDER

Application No. G-5485. Permit No. G-5389.
IN NAME OF

MERLIN L. CANTIN

Surveyed 12-19 1977, by R. BARWIN