


G-6351  
49877

T. IS. R. 25E. W.M.

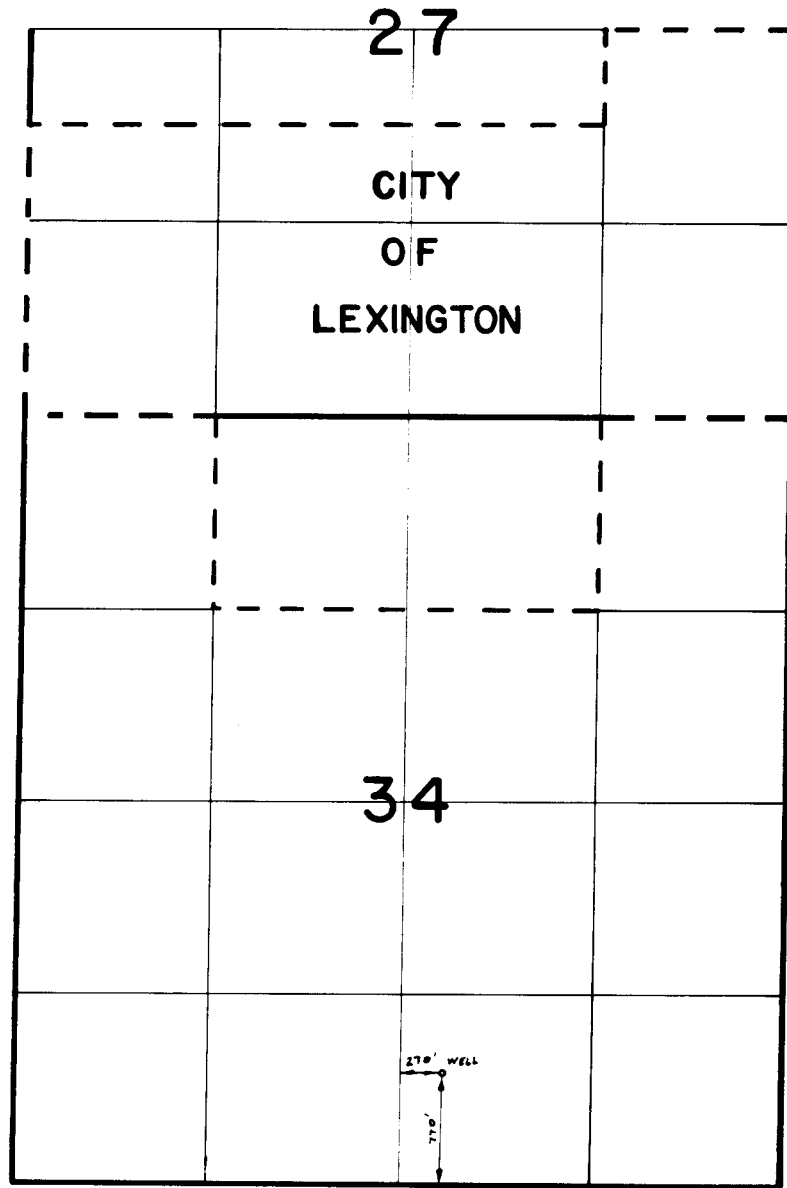

**FINAL PROOF SURVEY**  
UNDER

Application No. G-6714 Permit No. G-6351  
IN NAME OF

**CITY OF LEXINGTON**

Surveyed 11-21 1977, by R. BARWIN.

INSPECTION V.L.C.