


T. 2S. R. 39E. W.M.

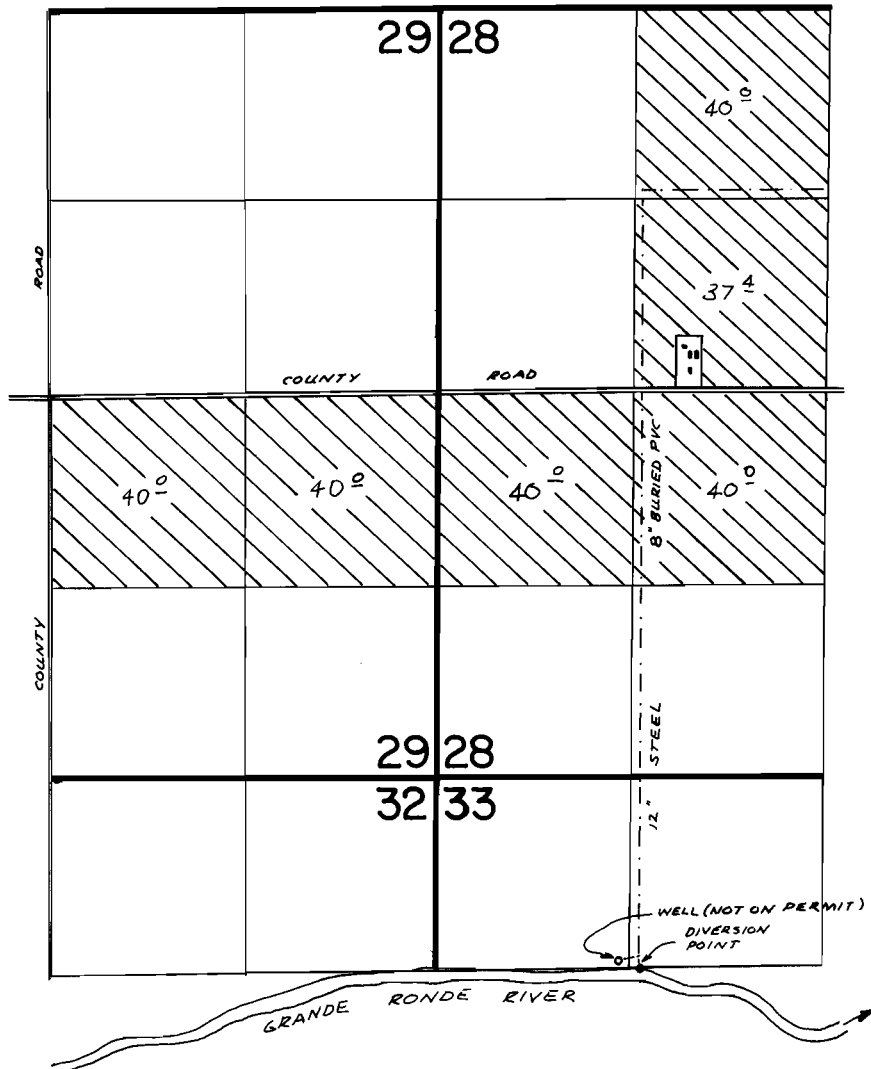

DIVERSION POINT LOCATED 1330' S. & 1400' E. FROM NW COR SEC 33
WELL LOCATED 1270' E. & 1280' S. FROM NW COR SEC 33

FINAL PROOF SURVEY UNDER

Application No. 49913 Permit No. 37561
IN NAME OF

DONALD D. HAMANN

Surveyed OCT. 18, 1977, by R. BARWIN