


T.5&6S.R.7W.W.M.

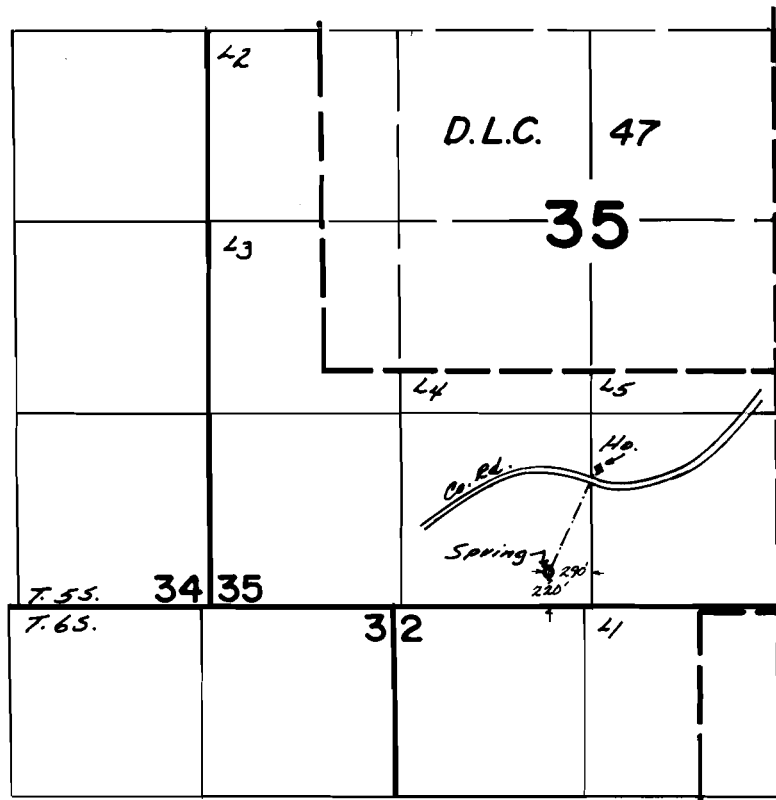

FINAL PROOF SURVEY UNDER

Application No. 53396.. Permit No. 39743..
IN NAME OF

JACK SMITH

Surveyed March 17, 1978, by L. H. Nunn