


T. 37S., R. 3E., W.M.

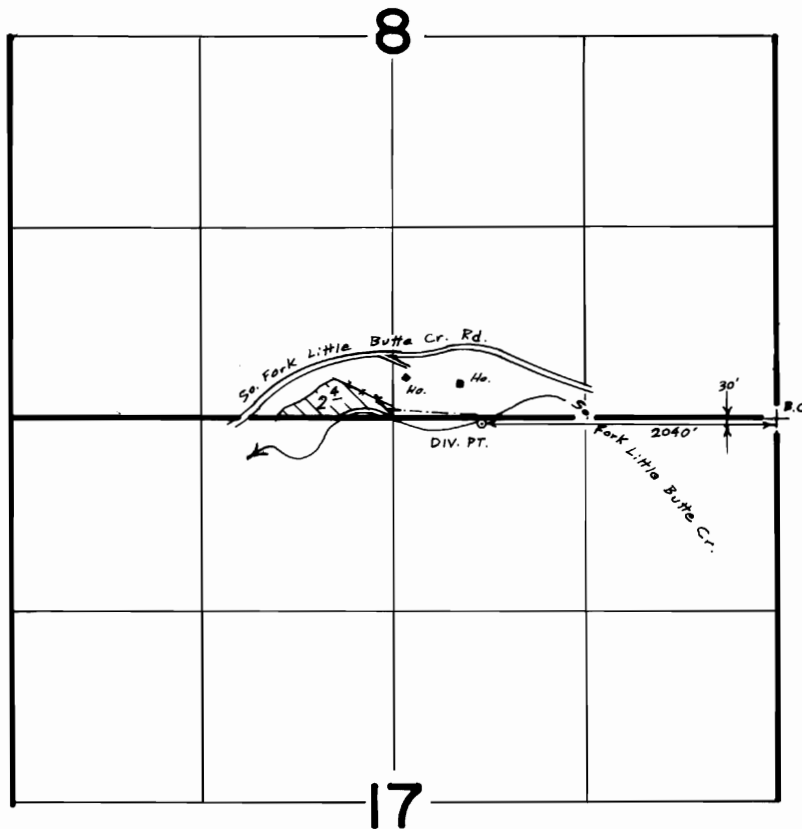

FINAL PROOF SURVEY
UNDER

Tr. no. 3659

Application No. Permit No.
IN NAME OF

.....JUANITA STOKES.....

Surveyed FEB. 5, 1981, by Bruce R. Sund