


T.12S. R.41&42E. W.M.

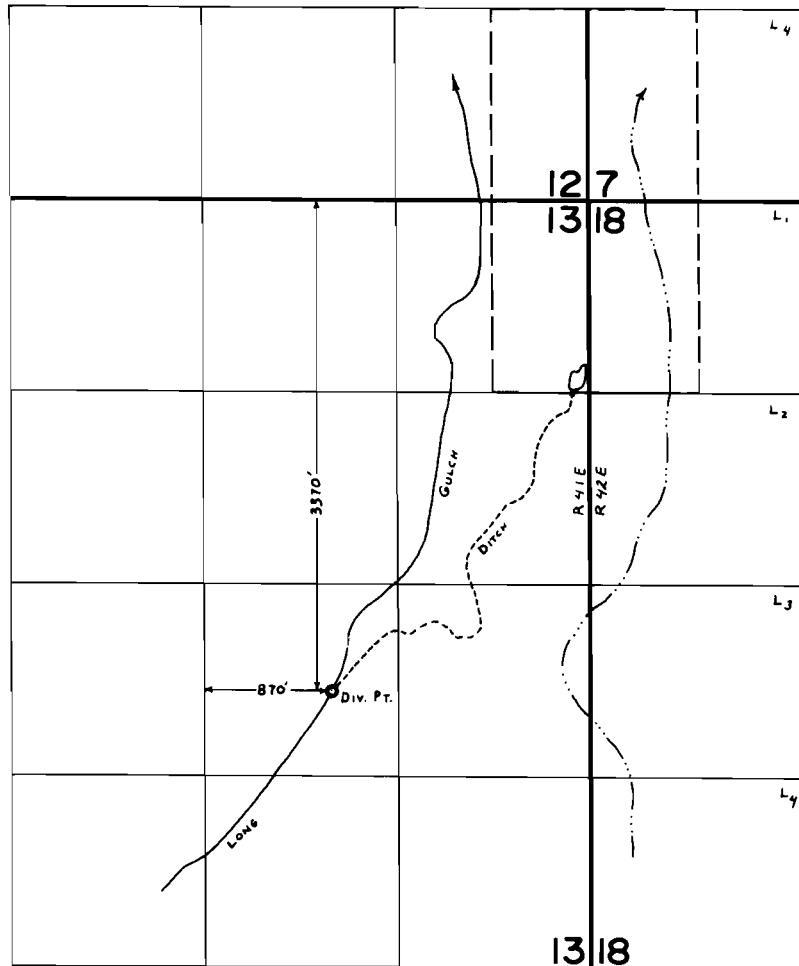

FINAL PROOF SURVEY
UNDER

Application No. 32761... Permit No. 25995.....
IN NAME OF

LLOYD M. McCOLLOUGH

Surveyed Nov. 1..... 1978, by R. Barwin.....