



T. 9 S. R. 1 E.

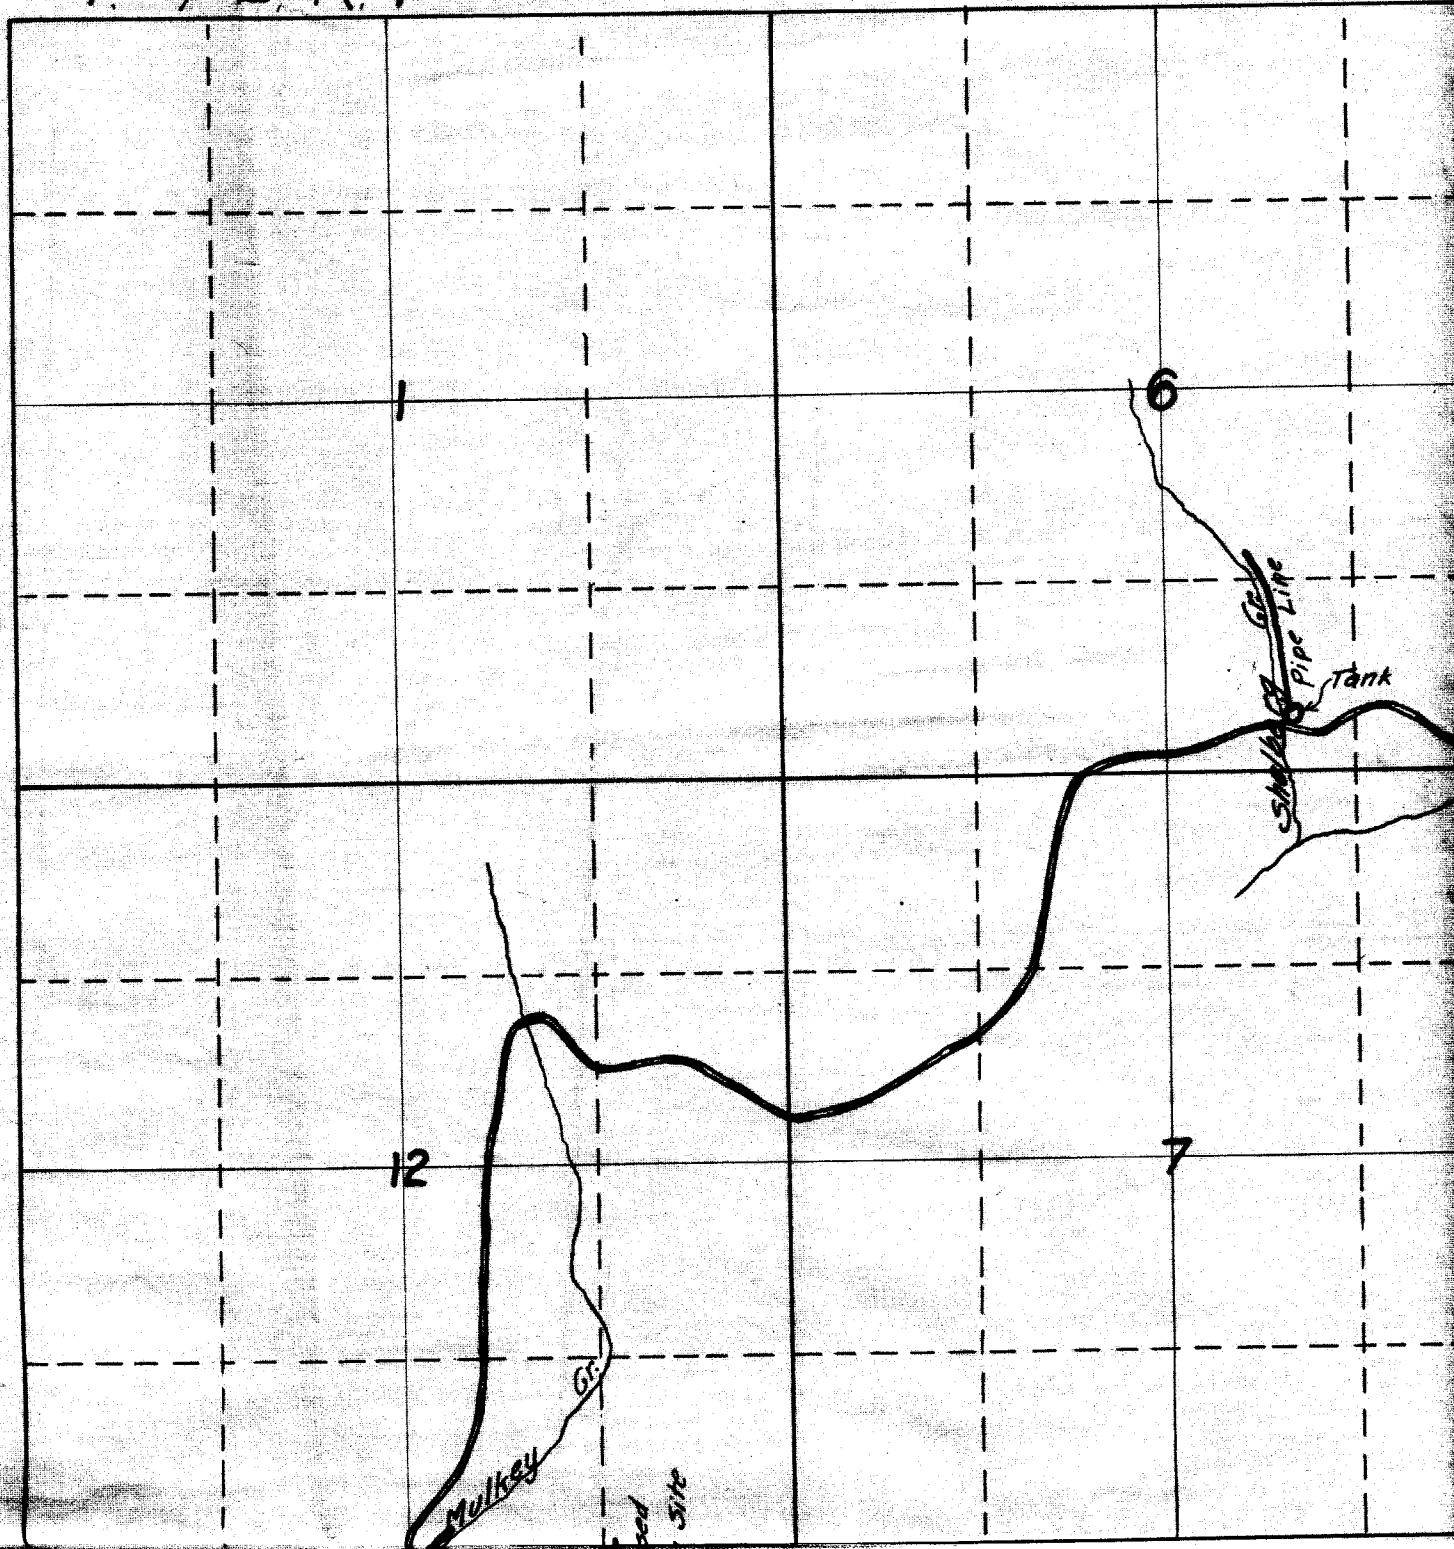

T 9 S. R. 2 E.

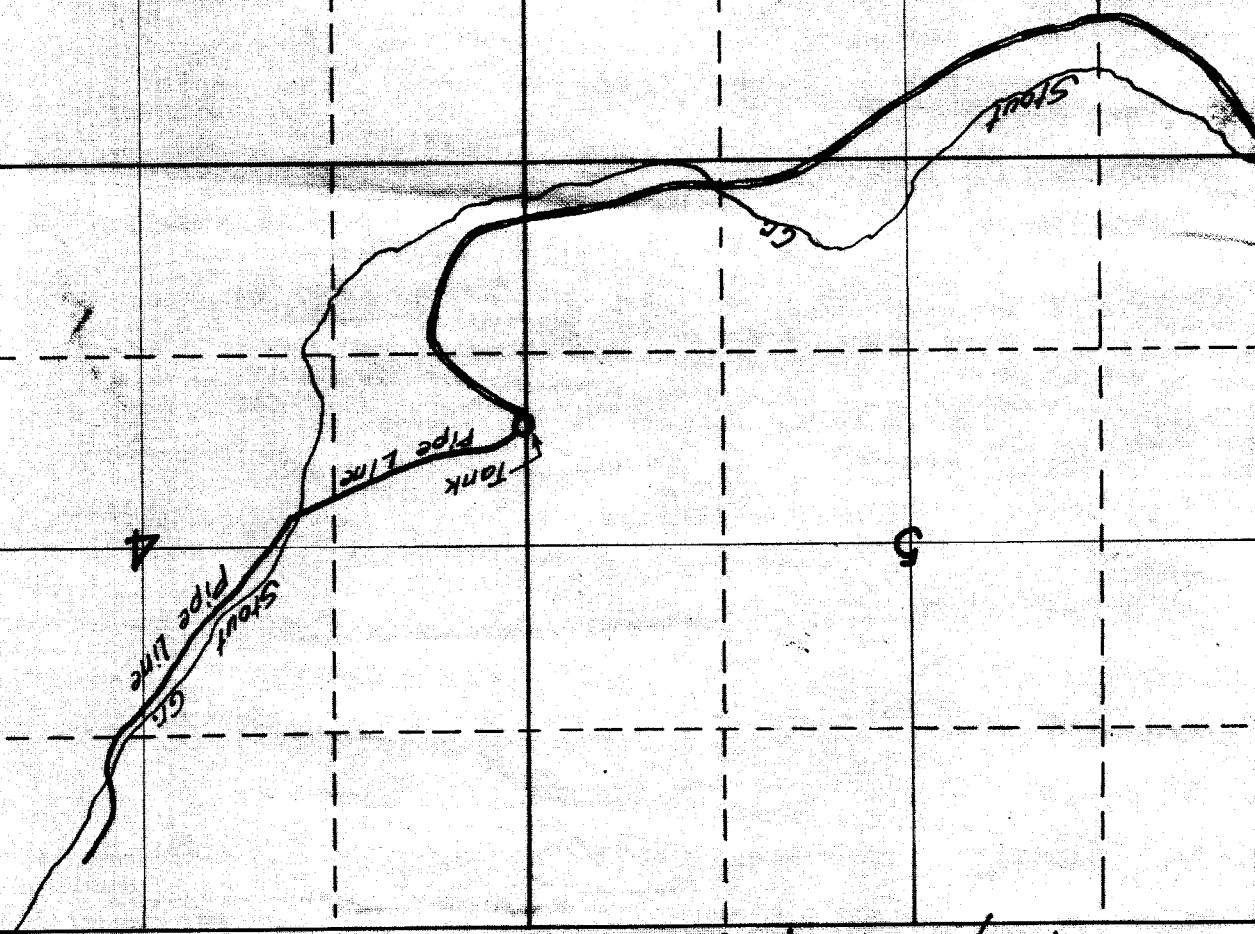


6

8

4

5

10010

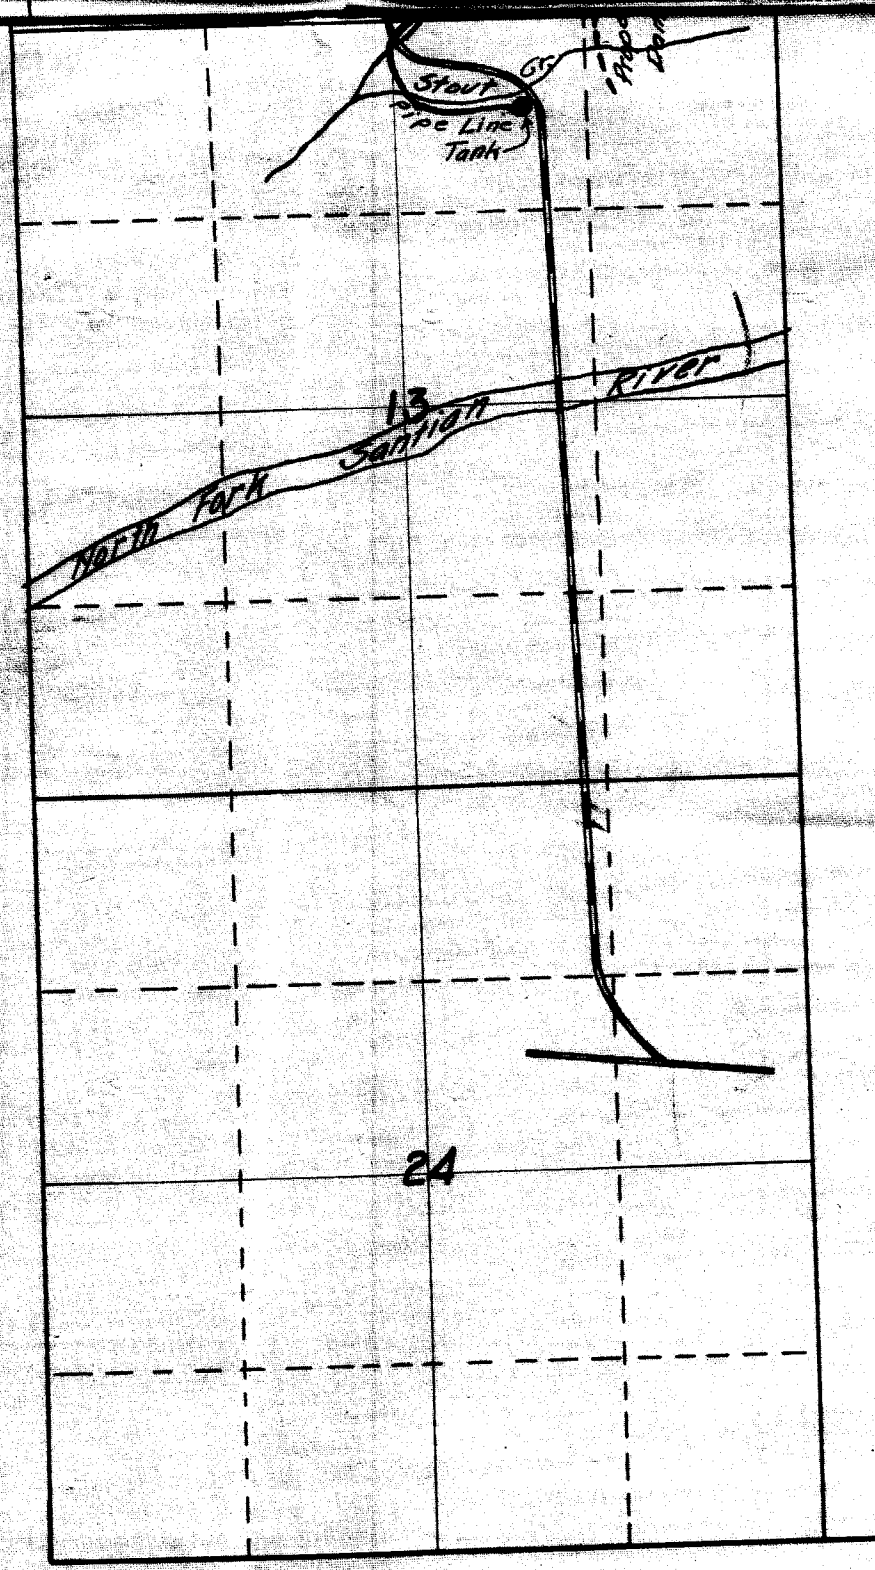

that
survey
and
paning
ditched

OFFICE OF STATE ENGINEER
RECEIVED
AUG 14 1920
SALEM, OREGON

Map of
SILVERTON LBR. CO'S RAILROAD
showing
STREET CROSSINGS & NAMES
& PIPE LINES IN USE

I, Harry C. Patton, of Mehama, Ore., do hereby certify
that the map was made from notes taken during an actual
survey by me (or under my immediate supervision) on Jan. 6, 1920.
It correctly represents the works described in the accom-
panying application, together with the location of streams and other
the immediate vicinity.

Harry C. Patton
Surveyor

Application No. 6976
Permit No. 4733
Certificate No. 4989