


T.13S., R.7W., W.M.

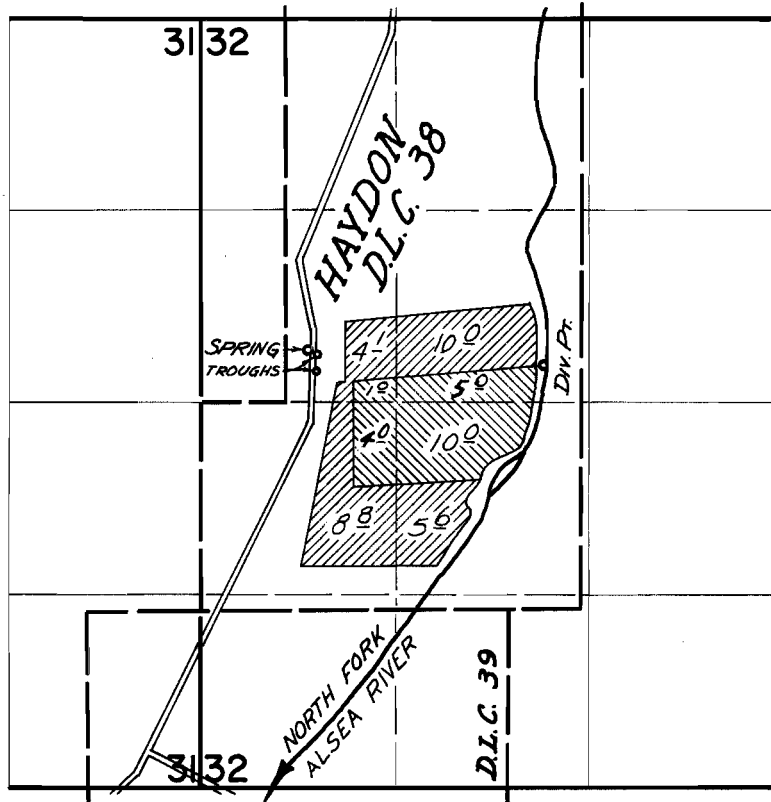

DIV. PT. LOCATED: 1670' N & 250' W ; SPRING LOCATED: 1780' N & 1880' W ; BOTH FROM SE COR. HAYDON DLC 38.

 PRIMARY
 SUPPLEMENTAL

FINAL PROOF SURVEY UNDER

Application No. 44491 Permit No. 33275
IN NAME OF

FLOYD M. STOUT

Surveyed August 23 1973, by D. Norby