


T.25S.,R.12W.,W.M.

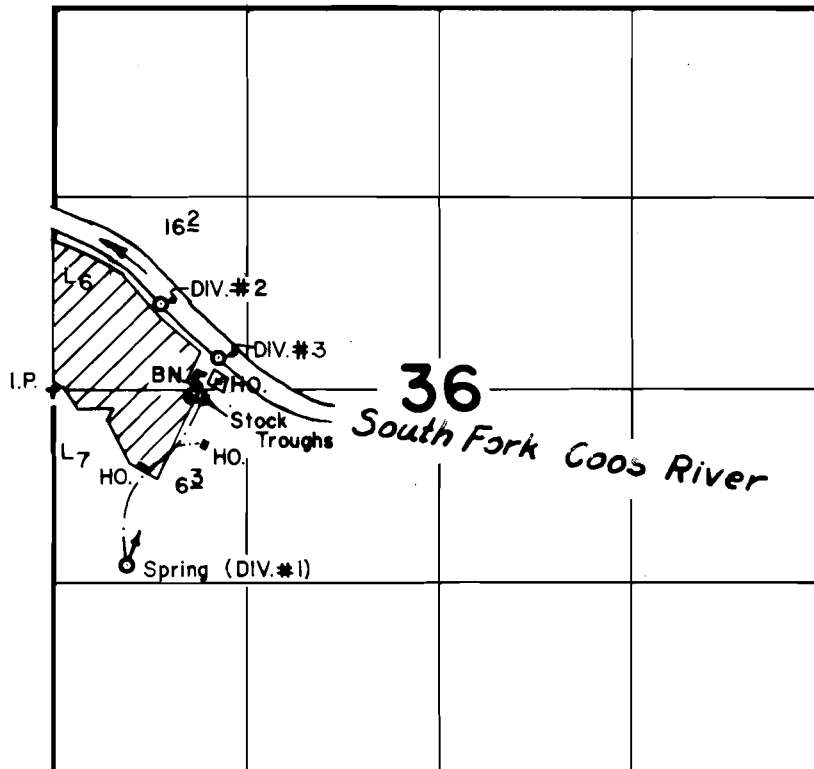

DIV. PTS. LOC: #1; 1210' S., & 500' E.; #2; 590' N. & 740' E.; #3; 220' N. & 1140' E., ALL FROM W. 1/4 COR., SEC. 36

FINAL PROOF SURVEY UNDER

Application No. 54311 Permit No. 40665
IN NAME OF

STIAN E. SMITH

Surveyed JULY 27, 1977, by D. NORBY