


T.41S.,R.13W.,W.M.

Application No. 54812
Permit No. 40827

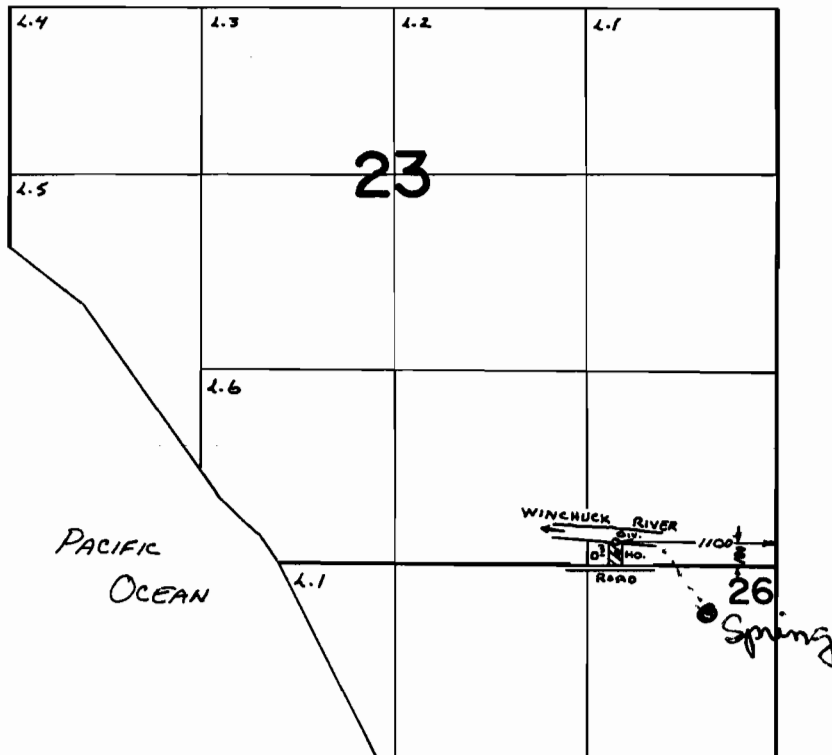

Sept 20 19 1976
C. C. AKIN
B. L. AKIN

FINAL PROOF SURVEY
UNDER

RECEIVED

SEP 21 1976
WATER RESOURCES DEPT
SALEM, OREGON

Application No. 51928 Permit No. 37742
IN NAME OF

CLARK C. AKIN

Surveyed July 19 1975 by L. Toll