


T. 41S. R. 13W. W.M.

Sec. 23

SW 1/4 SE 1/4

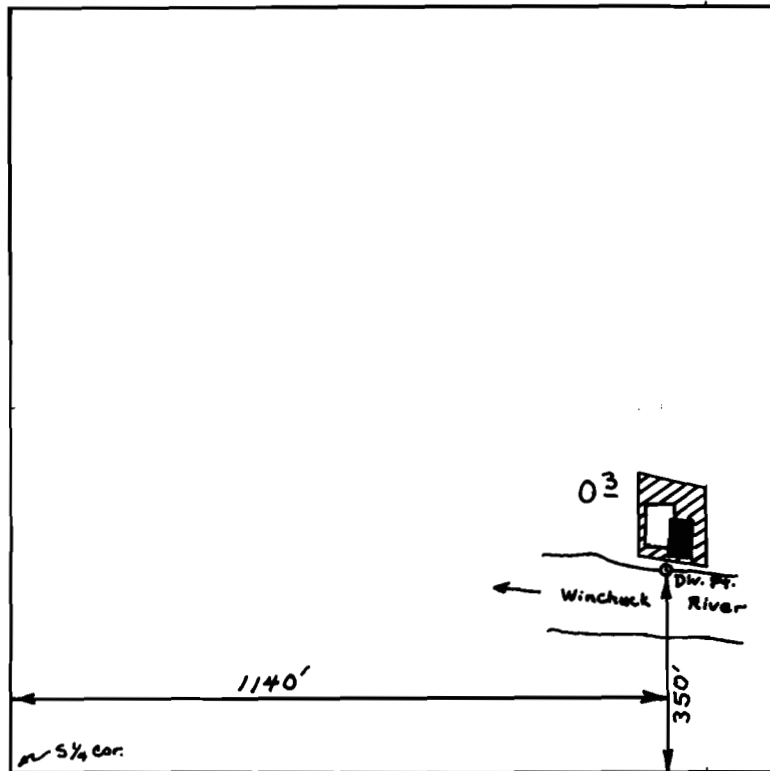

SCALE : 1" = 330'

**FINAL PROOF SURVEY  
UNDER**

Application No. 53039 Permit No. 40027  
IN NAME OF

JOHN & ELSIE BREWOLD

Surveyed Nov. 28, 1977, by D. Sparks