


T.26S. R.6W. W.M.

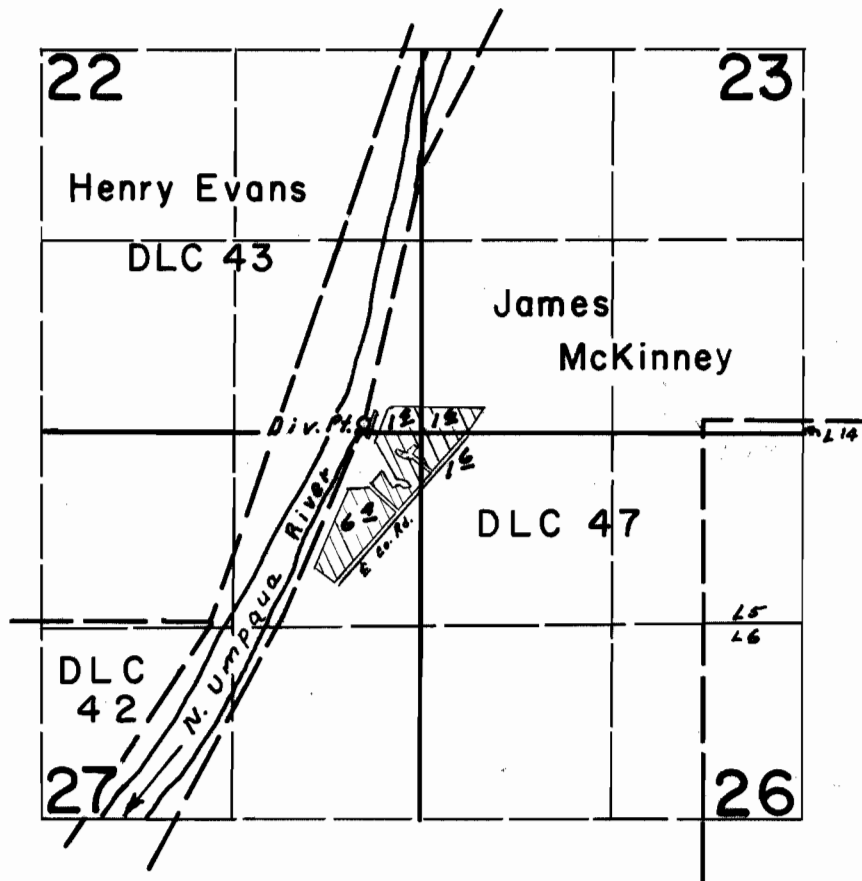

FINAL PROOF SURVEY
UNDER

Application No. 37877. Permit No. 28229.
IN NAME OF

CURTIS TRENT

Surveyed July 14, 1964, by *C. J. Gardner*