


T. 27 S., R. 2 W., W.M.

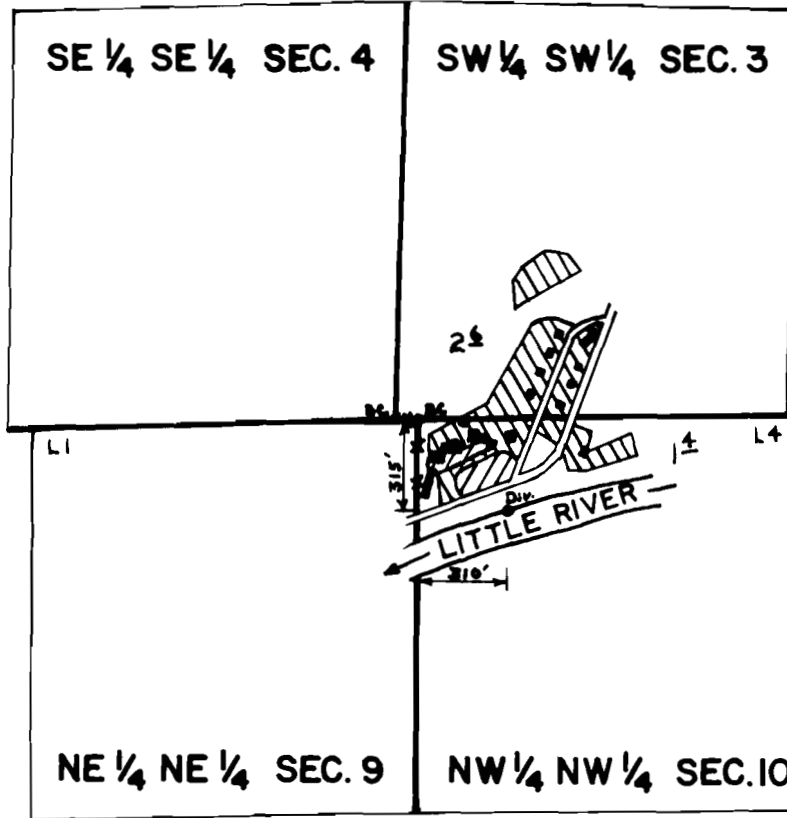

SCALE: 1" = 660'

 CERT. # 35324

FINAL PROOF SURVEY
UNDER

Application No. 53431... Permit No. 39758...
IN NAME OF

SOUTHERN ASSOCIATION OF CHRISTIAN CHURCHES

Surveyed MAY 9... 1978, by D.W. SPARKS...