


T.13S.R.27E.W.M.

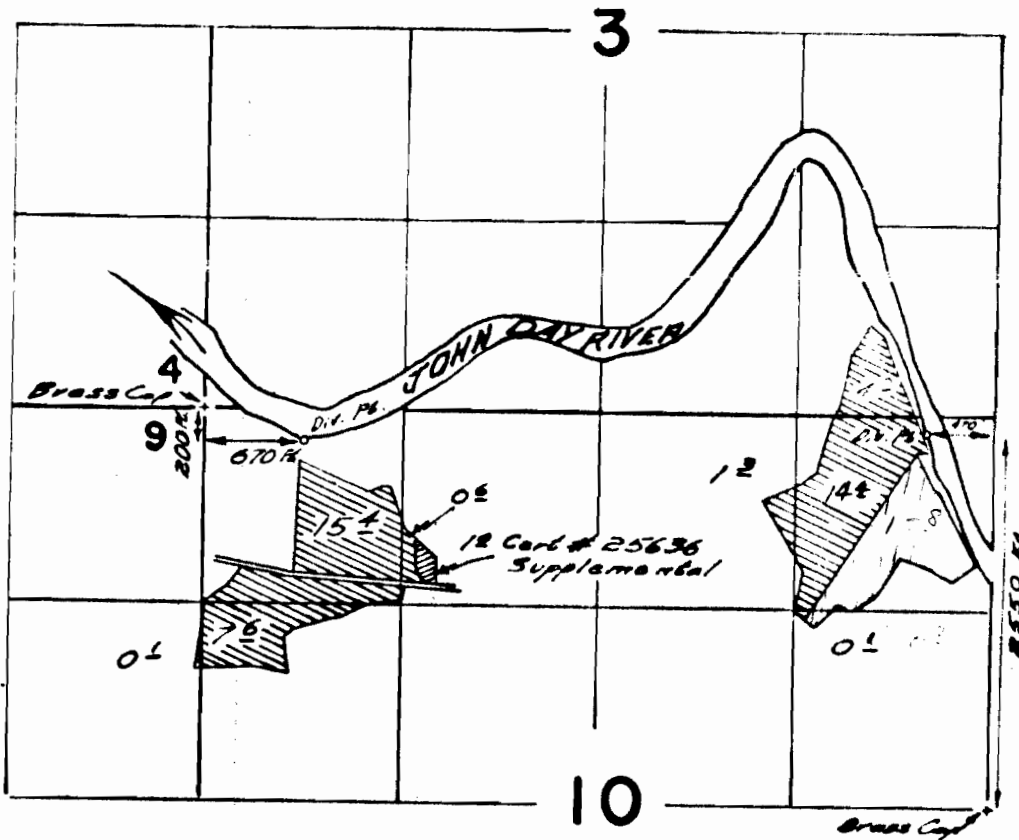

This application

Application No. *54910*
Permit No. *41188*

FINAL PROOF SURVEY
UNDER

Application No. *38184* Permit No. *28459*
IN NAME OF

ROY ZEILER

Surveyed *May 21 1968*, by *H. J. Ruppert*

RECEIVED
OCT 27 1976
DEPT. I
WATER RESOURCES
