


T.33 S., R.1 E., W.M.

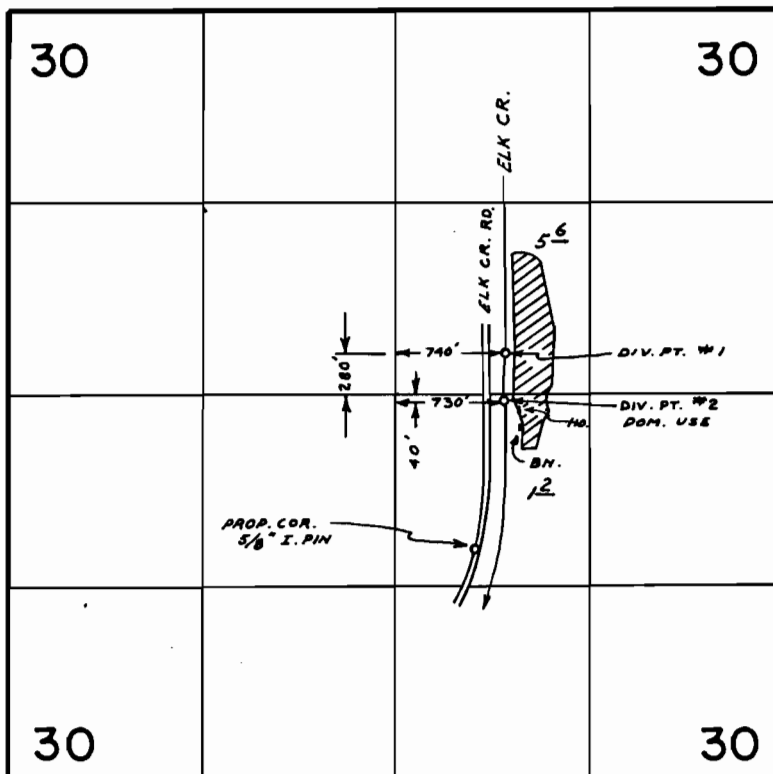

FINAL PROOF SURVEY UNDER

Application No. 50656 43726 Permit No. 38270 32684
 IN NAME OF

CHARLES E. PITTS

Surveyed AUG. 29 1978, by B. SUND