


# T. 37 S., R. 7 W., W.M.

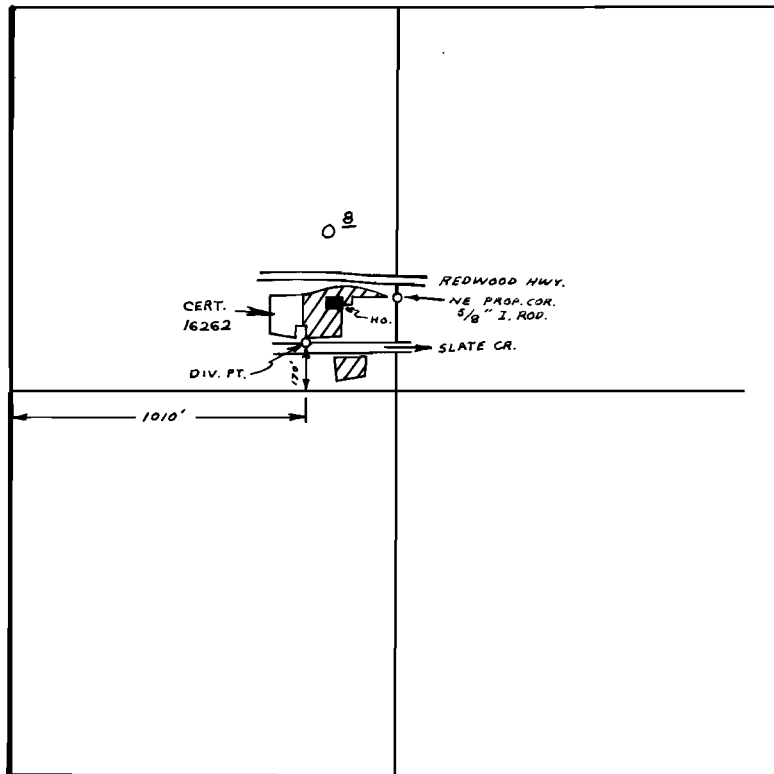

SCALE: 1" = 660 FT.

## FINAL PROOF SURVEY UNDER

Application No. 50361 Permit No. 37380  
IN NAME OF  
MERIL B. & LILLIAN FRITCHEY  
Surveyed JUL. 26 1978, by B. SUND