


T.15S. R.4W., W.M.

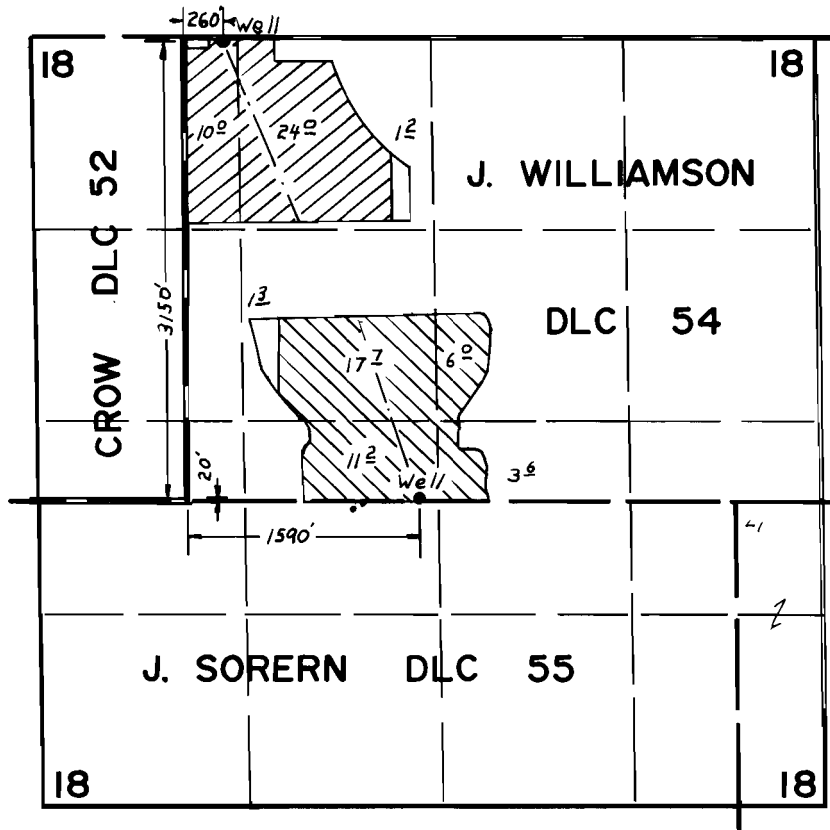

-  App'l. G-6464
-  App'l. G-7835

FINAL PROOF SURVEY UNDER

G-6464 G-6365
 Application No. G-7835 Permit No. G-7216.
 IN NAME OF

.....RAYMOND JAGER.....

Surveyed APR. 24, 1978, by J. S. DONALDSON