


T.17S. R.3W., W.M.

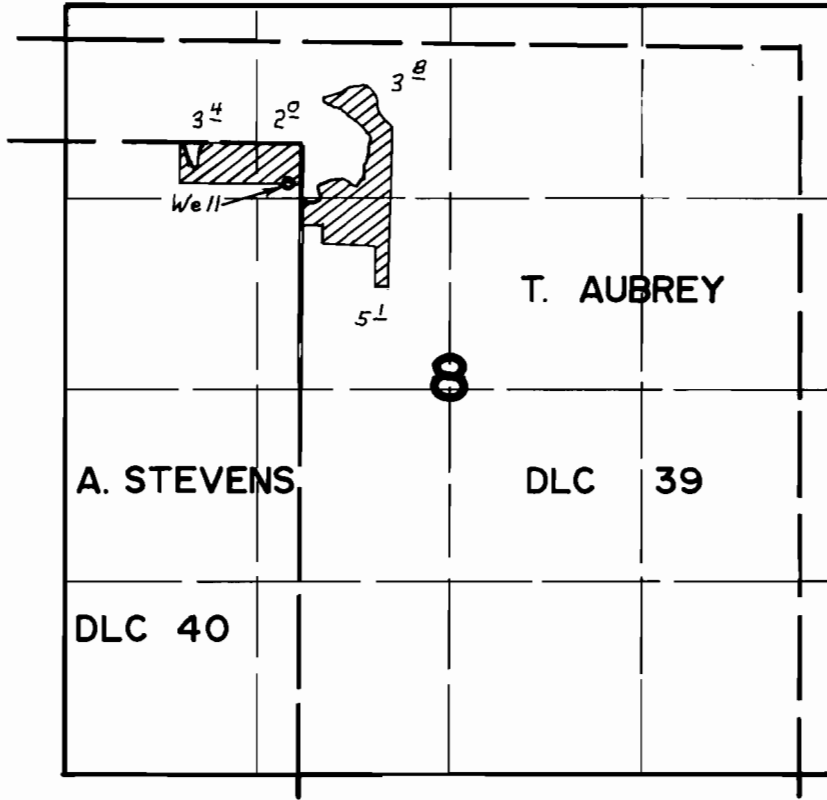

Well Loc. 280'S. & 90'W. From N.E. Cor. D.L.C. 40

**FINAL PROOF SURVEY
UNDER**

**Application No. G-6983. Permit No. G-6490.
IN NAME OF**

.....DOMINIQUE MINABERRIGARY.....

Surveyed MAY 15 1978, by J.S. DONALDSON