


# T.17S. R.5W. W.M.

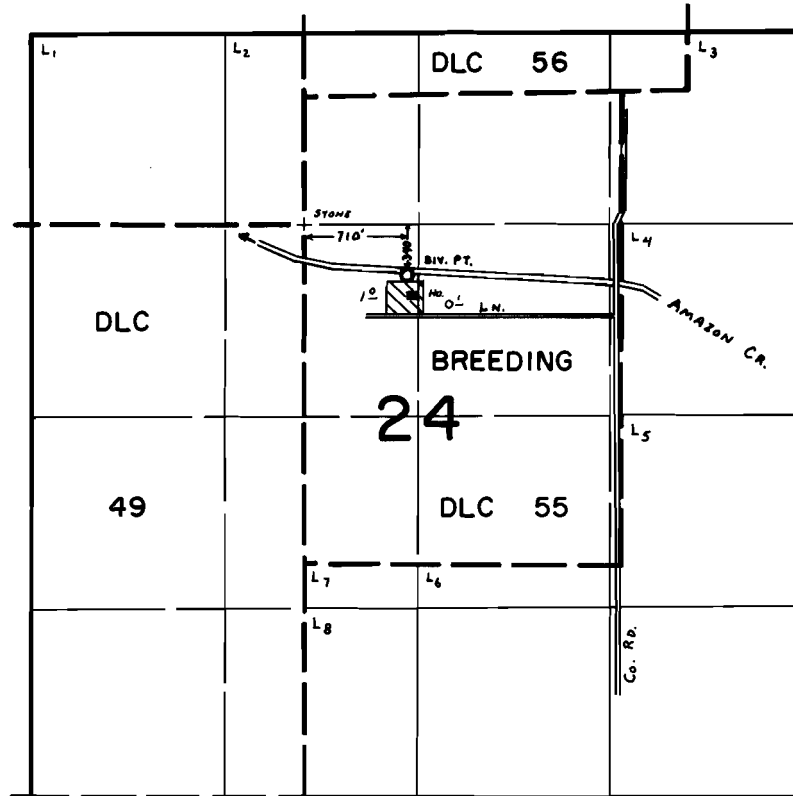

## FINAL PROOF SURVEY UNDER

Application No. 50530. Permit No. 37288.....  
IN NAME OF

.....James L. & Bebe J. Fleming.....

Surveyed June 20, 1979, by C. L. HUGHES.....